

MISSISSIPPI DEPARTMENT OF NATURAL RESOURCES
Bureau of Land and Water Resources
 Southport Mall
 P.O. Box 10631
 Jackson, Mississippi 39209
WATER WELL DRILLERS LOG

Marion
K
2079

7-26 19 84 Hollinger Marion
 date well completed firm name county well located

LANDOWNER: <u>Bonnie Rysteb</u> <u>Rt 6</u>	description of formations encountered	from	to
<u>Columbia, MS</u> (mailing address)	<u>sand, gravel</u> <u>sand, pea gravel</u>	<u>0</u> <u>20</u>	<u>20</u> <u>53</u>
WELL LOCATION: sec. <u>29</u> T <u>8(N)</u> S R. <u>18</u> E <u>6</u> miles <u>SW</u> of <u>Columbia</u> (distance) (direction) (nearest town)			
WELL PURPOSE: (home, irrigation, municipal, industrial)			
WELL COMPLETION DATA:			
(1) diameter (inches) <u>2"</u>			
(2) total depth (feet) <u>53</u>			
(3) static water level (feet) <u>30</u> <u>below</u> <u>above</u> top of ground.			
(4) casing <u>PVC</u> , <u>53</u> , (material) (depth)			
_____ If telescope see back. (size)			
(5) screen <u>5</u> , <u>48</u> (length) (depth to top)			
_____ <u>PVC</u> (size) (material)			
(6) pump <u>1</u> <u>9</u> (HP) (yield gpm)			
<u>elect.</u> (type power)			
(7) electric log _____ (yes or no)			
_____ (organization running log)			
(8) how well bottom plugged <u>sand</u> <u>SHM 1C</u>			
DRILLERS REMARKS: <u>Good well</u>			


MISSISSIPPI DEPARTMENT OF NATURAL RESOURCES
 BUREAU OF LAND & WATER RESOURCES

OCT 2 1984

RECEIVED

If well telescopes please sketch and show depths.

GROUND LEVEL

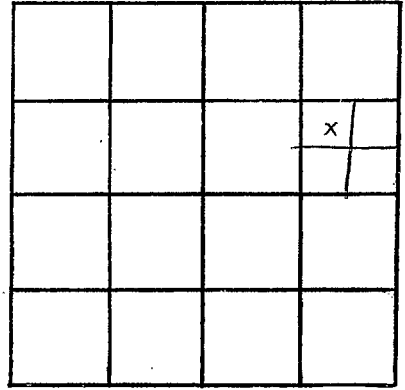

SECTION 29

Please indicate well location X.

ADDITIONAL INFORMATION

If more than one screen, show locations of each on sketch.