

MISSISSIPPI DEPARTMENT OF NATURAL RESOURCES

Bureau of Land and Water Resources

Southport Mall

P.O. Box 10631

Jackson, Mississippi 39209

WATER WELL DRILLERS LOG

<u>MAKON</u>
<u>R 2080</u>
<u>11/1/86</u>

19 1986 date well completed      Tom Griffith Well Service firm name      \_\_\_\_\_ county well located

LANDOWNER: <u>Donnie Powell</u>	description of formations encountered	from	to
		<u>SAND</u>	<u>0</u>
	<u>Gravel</u>	<u>20</u>	<u>100</u>

(mailing address)

WELL LOCATION:  
 sec 10 T 3 N R 19 E  
S W  
 \_\_\_\_\_ miles \_\_\_\_\_ of Columbia  
 (distance) (direction) (nearest town)

WELL PURPOSE: Home  
 (home, irrigation, municipal, industrial)

- WELL COMPLETION DATA:
- diameter (inches) 4"
  - total depth (feet) 100'
  - static water level (feet) \_\_\_\_\_ below above top of ground.
  - casing PVC, 80'  
(material), (depth)  
4" if telescope see back.  
(size)
  - screen 20', 80'  
(length), (depth to top)  
4", PVC  
(size), (material)
  - pump \_\_\_\_\_ 40  
(HP), (yield gpm)  
 \_\_\_\_\_  
(type power)
  - electric log No  
(yes or no)  
NA  
(organization running log)
  - how well bottom plugged \_\_\_\_\_  
BAV

DRILLERS REMARKS: \_\_\_\_\_


**REGISTERED**

NOV 7 1986

Department of Natural Resources  
 Bureau of Land & Water Resources

If well telescopes please sketch and show depths.

GROUND LEVEL

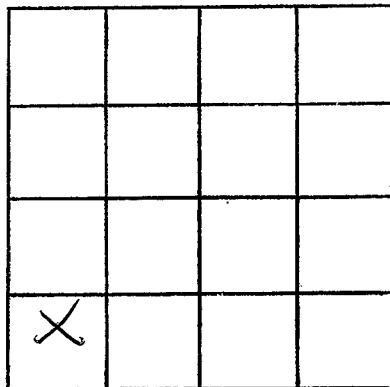

SECTION \_\_\_\_\_

Please indicate well location X.

ADDITIONAL INFORMATION

If more than one screen,  
show locations of each on sketch.