

Marion  
K 2081

MISSISSIPPI DEPARTMENT OF NATURAL RESOURCES  
 Bureau of Land and Water Resources  
 Southport Mall  
 P.O. Box 10631  
 Jackson, Mississippi 39209  
**WATER WELL DRILLERS LOG**

7198

10-21-86 date well completed    Tom Griffith Well Service firm name    Marion county well located

LANDOWNER: Donnie Powell  
Rt 1 Box 81  
Foxworth Ms  
 (mailing address)

description of formations encountered	from	to
<u>Red Sand</u>	<u>0</u>	<u>10</u>
<u>Red Gravel</u>	<u>10</u>	<u>20</u>


WELL LOCATION:  
 sec 28 T 4 N R 13 E  
1 miles E of Foxworth  
 (distance) (direction) (nearest town)

WELL PURPOSE: Home  
 (home, irrigation, municipal, industrial)

WELL COMPLETION DATA:

- (1) diameter (inches) 2"
- (2) total depth (feet) 20'
- (3) static water level (feet) 18 below above top of ground.
- (4) casing PVC 75'  
 (material) (depth)  
2" if telescope see back.  
 (size)
- (5) screen 15' 75'  
 (length) (depth to top)  
2" PVC  
 (size) (material)
- (6) pump 1 30 air lift  
 (HP) (yield gpm)  
cell 20 pump  
 (type power)
- (7) electric log No  
 (yes or no)  
NA  
 (organization running log)
- (8) how well bottom plugged BWV


DRILLERS REMARKS: \_\_\_\_\_

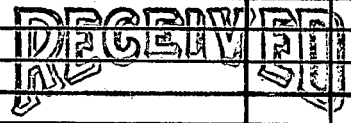

SEP 24 1987  
 Department of Natural Resources  
 Bureau of Land & Water Resources

If well telescopes please sketch and show depths.

GROUND LEVEL

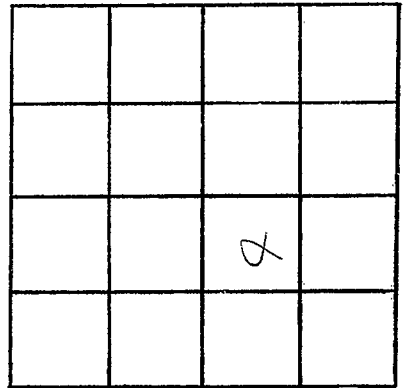

SECTION 28

Please indicate well location X.

ADDITIONAL INFORMATION

If more than one screen,  
show locations of each on sketch.