

MARION
K 2082
3/8/77

MISSISSIPPI
BOARD OF WATER COMMISSIONERS
416 North State Street
130 Jackson, Mississippi 39201

WATER WELL DRILLERS LOG


3/8 1977 Hollinger Water Well Marion
date well completed firm name county well located

LANDOWNER: Jake Forbes RT1	description of formations encountered	from	to
Foxworth, Miss (mailing address)	Clay sand sand, gravel sand	0 40 60	40 60 120
<p>WELL LOCATION: sec. 7 T 36 N R 13 E 3 1/2 miles W of Foxworth (distance) (direction) (nearest town)</p>			
<p>WELL PURPOSE: Home (home, irrigation, municipal, industrial)</p>			
<p>WELL COMPLETION DATA:</p>			
(1) diameter (inches) 2"			
(2) total depth (feet) 120			
(3) static water level (feet) _____ below above top of ground.			
(4) casing PVC 120 (material) (depth)			
_____ (size) if telescope see back.			
(5) screen 5 115 (length) (depth to top)			
2" PVC (size) (material)			
(6) pump 1 9 (HP) (yield gpm)			
elect (type power)			
(7) electric log _____ (yes or no)			
_____ (organization running log)			
(8) how well bottom plugged: sand shale			
DRILLERS REMARKS: good well			

RECEIVED
APR 26 1977
MISS. BD. OF WATER

If well telescopes please sketch and show depths.

GROUND LEVEL

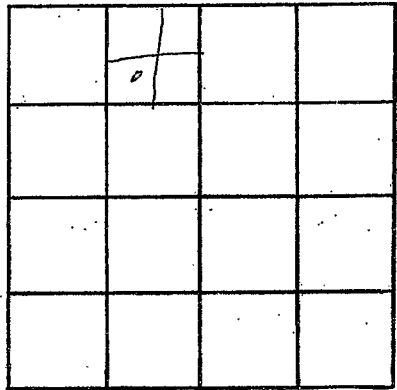

SECTION 7

Please indicate well location X.

ADDITIONAL INFORMATION

If more than one screen,
show locations of each on sketch.