

MISSISSIPPI DEPARTMENT OF NATURAL RESOURCES

Bureau of Land and Water Resources

P.O. Box 10631

Jackson, Mississippi 39209

WATER WELL DRILLERS LOG

COUNTY WELL LOCATED <i>Monroe</i>	
WELL NUMBER <i>K 2083</i>	CODED
DATE WELL COMPLETED <i>4/9/90</i>	

PERMIT NUMBER <i>0-508</i>
NAME OF DRILLING FIRM <i>Gordon Well Dr.</i>

NAME & MAILING ADDRESS OF LANDOWNER <i>John Boyles</i>

WELL LOCATION: SEC <i>3</i> TOWNSHIP <i>3</i> RANGE <i>13</i> ^N _S ^W _W

DISTANCE <i>1</i> Miles <i>north</i> of <i>Jopworth</i>
OTHER LANDMARK

WELL PURPOSE: Home, Irrigation, Municipal, Industrial, Fish Pond, etc.

PUMP DATA

PUMP TYPE (Circle One):
Submersible, Turbine, Jet, Flowing Well,
Other (Describe) _____

POWER TYPE (Circle One):
Electric, Tractor, Diesel, Gasoline, Butane,
Other (Describe) _____ H/P _____

Pump Capacity (GPM)	No. of Stages	Setting Depth	FT.
---------------------	---------------	---------------	-----

PUMP TEST

Well yielded _____ GPM with
a drawdown of _____ ft.
after _____ hours of pumping

WELL DATA

Well Depth <i>170</i>	Casing Diameter (In.) <i>4"</i>	Casing Length (Fl.) <i>160</i>
Type of Casing <i>PVC</i>	Hole Depth <i>170</i>	Depth to Static Water Level <i>15</i>

TYPE OF COMPLETION: (Circle One or More):
Gravel Packed, Underreamed, Telescoped,
Natural Development, Open Hole, Other
(Describe) _____

Top of Lap Pipe or Reduction in Casing

FEET IF TELESCOPED OR MORE THAN ONE SCREEN: USE BACK PAGE

SCREEN DATA

Diameter - Inches <i>4</i>	Length - Feet <i>10</i>	Slot Size - Inches <i>1/2</i>
Screen Type <i>PVC</i>	Depth to Bottom - Feet <i>160</i>	

LOG DATA

TYPE OF LOG RUN (Circle One): No Log Run,
Electric, Gamma Ray, Density, Sonic, Neutron,
Other (Describe) _____

Name of Organization Running Log

GEOLOGIC DATA (Office Use Only)

Surface Elev.	Geologic Unit	Unit Thickness	Depth to Top
Subs. SWL	Date	Analysis	Aquifer Test


Driller's Remarks

DESCRIPTION OF FORMATIONS ENCOUNTERED	FROM	TO	FORMATIONS (Continued)	FROM	TO
<i>top soil</i>	<i>0</i>	<i>1</i>	<div style="font-size: 2em; font-weight: bold; opacity: 0.5;">RECEIVED</div> <div style="font-size: 1.5em; font-weight: bold; margin-top: 10px;">APR 20 1990</div> <div style="font-size: 0.8em; margin-top: 10px;"> Department of Natural Resources Bureau of Land & Water Resources </div>		
<i>reddish clay</i>	<i>1</i>	<i>30</i>			
<i>light & bluish</i>	<i>30</i>	<i>40</i>			
<i>clay</i>	<i>40</i>	<i>150</i>			
<i>sand</i>	<i>150</i>	<i>170</i>			

IF MORE SPACE IS NEEDED, USE BACK

If well telescopes please sketch and show depths.

GROUND LEVEL

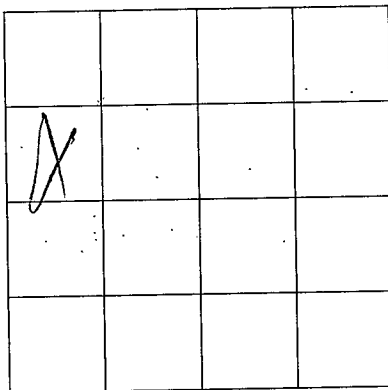

SECTION 3

Please indicate well location X.

ADDITIONAL INFORMATION

If more than one screen,
show location of each on sketch.