

Bureau of Land and Water Resources

PERMIT NUMBER
0-402

NAME OF DRILLING FIRM
Tom Griffith
Columbia, Mo.

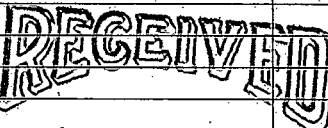
Jackson, Mississippi 39209
WATER WELL DRILLERS LOG

PUMP DATA		
PUMP TYPE (Circle One):		
Submersible,	Turbine,	Jet
Other (Describe) _____		
Flowing Well, _____		
PUMP TYPE (Circle One):		
Electric,	Tractor,	Diesel,
Gasoline, Butane,		
Other (Describe) _____		
12	10	60
Pump Capacity (GPM)		Setting Depth
FT.		
PUMP TEST		
800 GPM w/ AIR		
Well yielded 12 GPM with		
a drawdown of _____ ft.		
after _____ hours of pumping		

LOG DATA	
TYPE OF LOG RUN (Circle One):	No Log Run
Electric, Gamma Ray, Density, Sonic, Neutron, Other (Describe)	
Name of Organization Running Log	

Surface Elev.	Geologic Unit	Unit Thickness	Depth to Top
Subs. SWL	Date	Analysis	Aquifer Test

Driller's Remarks

DESCRIPTION OF FORMATIONS ENCOUNTERED	FROM	TO	FORMATIONS (Continued)	FROM	TO
Clay Sand & Gravel	0 15	15 100	 OCT 03 1990 Department of Natural Resources Bureau of Land & Water Resources		
			IF MORE SPACE IS NEEDED, USE BACK		

If well telescopes please
sketch and show depths.

GROUND LEVEL

SECTION _____

Please indicate well location X.

ADDITIONAL INFORMATION

If more than one screen,
show location of each on sketch.