

MISSISSIPPI DEPARTMENT OF NATURAL RESOURCES

Bureau of Land and Water Resources

Southport Mall

P.O. Box 10631

Jackson, Mississippi 39209

WATER WELL DRILLERS LOG

MARION
K 2085

9-19 1990
date well completed

Hollinger Well
firm name *Service*

Marion
county well located

LANDOWNER: *Charles Rogers*
PO Box 569
Columbia, MS 39429
(mailing address)

description of formations encountered	from	to
<i>Chalk</i>	<i>0</i>	<i>20</i>
<i>pea gravel</i>	<i>20</i>	<i>30</i>
<i>Chalk</i>	<i>30</i>	<i>160</i>
<i>coarse sand, gravel</i>	<i>160</i>	<i>200</i>

WELL LOCATION:
sec. ~~30~~ T ~~30~~ N ~~13~~ E
S
2 miles NW of *Foxworth*
(distance) (direction) (nearest town)

WELL PURPOSE: *camp*
(home, irrigation, municipal, industrial)

WELL COMPLETION DATA:

(1) diameter (inches) *4"*

(2) total depth (feet) *200*

(3) static water level (feet) *6"* below above top of ground.

(4) casing *PVC*, *180*,
(material) (depth)
(size) if telescope see back.

(5) screen *20*, *180*
(length) (depth to top)
4", *PVC*
(size) (material)

(6) pump *1*, *20*
(HP) (yield gpm)
elect
(type power)

(7) electric log (yes or no) _____
(organization running log) _____



OCT 09 1990


Department of Natural Resources
Bureau of Land & Water Resources

(8) how well bottom plugged *SAND SHARK*

DRILLERS REMARKS: *very good well*

If well telescopes please sketch and show depths.

GROUND LEVEL

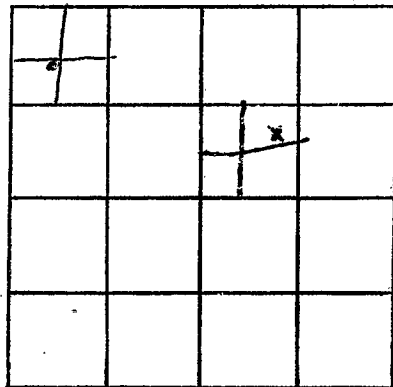

Section 3

SECTION 30

Please indicate well location X.

ADDITIONAL INFORMATION

If more than one screen,
show locations of each on sketch.