

MISSISSIPPI DEPARTMENT OF NATURAL RESOURCES

Bureau of Land and Water Resources

Southport Mall

P.O. Box 10631

Jackson, Mississippi 39209

WATER WELL DRILLERS LOG

MARION
K 2087

10-2

date well completed

1990 Hollinger Well Service Marion

firm name

county well located

LANDOWNER: Johnny Sumrell

RT1 Foxworth, MS
(mailing address)

description of formations encountered

from

to


WELL LOCATION:
sec 33 T-3 N 13E R-10 E
2 miles NW of Foxworth
(distance) (direction) (nearest town)

Chalk	0	20
gravel	20	40
Chalk	40	120
sand gravel	120	160
Chalk	160	240
sand gravel	240	360
coarse sand	360	400

WELL PURPOSE: Fish Pond
(home, irrigation, municipal, industrial)

WELL COMPLETION DATA:

- (1) diameter (inches) 3"
- (2) total depth (feet) 400
- (3) static water level (feet) flow below above top of ground.
- (4) casing PVC (material) 1 (depth)
(size) if telescope see back.
- (5) screen 28 (length) 372 (depth to top)
3" (size) PVC (material)
- (6) pump None (HP) 50 GPM (yield gpm)
(type power)
- (7) electric log (yes or no) _____
(organization running log) _____
- (8) how well bottom plugged Artesian well

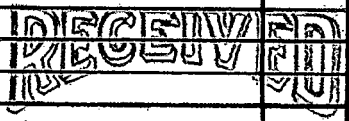

OCT 09 1990


Department of Natural Resources
Bureau of Land & Water Resources

DRILLERS REMARKS:

Very Good well

If well telescopes please sketch and show depths.

GROUND LEVEL

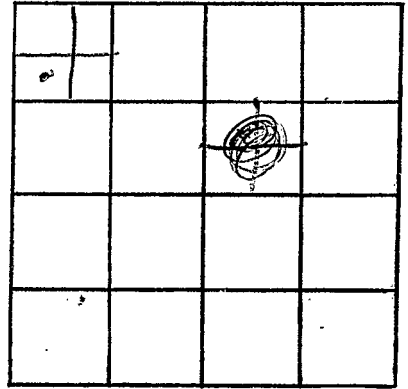

SECTION 03

Please indicate well location X.

ADDITIONAL INFORMATION

If more than one screen,
show locations of each on sketch.