

MISSISSIPPI DEPARTMENT OF NATURAL RESOURCES

Bureau of Land and Water Resources

Southport Mall

P.O. Box 10631

Jackson, Mississippi 39209

WATER WELL DRILLERS LOG

MARION
R 2089

6-5
date well completed

1931 Hollier Well
firm name

Spartan
county well located

LANDOWNER: Stanley & Thelma
R-1
Forsyth 572 one
(mailing address)

description of formations encountered	from	to
Hard granite	0	6.0
Shale	6.0	12.0
Loose sand, gravel	12.0	185

WELL LOCATION:

sec. 15 T-3 N R-13 E
1 miles W of Forsyth
(distance) (direction) (nearest town)

WELL PURPOSE:
(home, irrigation, municipal, industrial)

WELL COMPLETION DATA:

- (1) diameter (inches) 2"
- (2) total depth (feet) 185
- (3) static water level (feet) 8 below top of ground
- (4) casing PVC, 175 (material) (depth)

If telescope see back.
(size)

- (5) screen 10, 175 (length) (depth to top)
- 2" PVC (size) (material)

- (6) pump NONE (HP) (yield gpm)
- (type power)

- (7) electric log (yes or no)


(organization running log)

- (8) how well bottom plugged Sand Shrink

DRILLERS REMARKS: Very Good Well

If well telescopes please sketch and show depths.

GROUND LEVEL

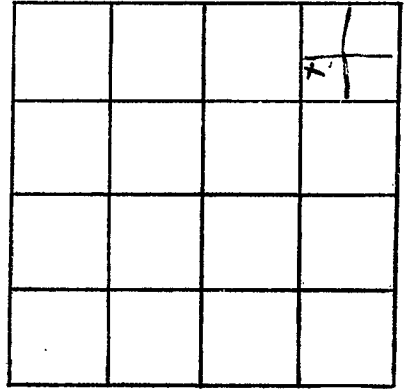

SECTION 15

Please indicate well location X.

ADDITIONAL INFORMATION

If more than one screen,
show locations of each on sketch.