

MISSISSIPPI DEPARTMENT OF NATURAL RESOURCES

Bureau of Land and Water Resources

Southport Mall

P.O. Box 10631

Jackson, Mississippi 39209

WATER WELL DRILLERS LOG

Marion
K 2092

4-15 1993
date well completed

Hollinger Well
firm name

Marion
county well located

LANDOWNER: Joe Stringer
Hay 98 W
Foxworth, MS. 39483
(mailing address)

description of formations encountered

from to

Red clay	0	40
Chalk	40	120
Sand, gravel	120	260

WELL LOCATION:

sec. 20 T. 3 N. R. 13 E.
1 1/2 miles W of Foxworth
(distance) (direction) (nearest town)

WELL PURPOSE: Business
(home, irrigation, municipal, industrial)

WELL COMPLETION DATA:

- (1) diameter (inches) 4"
- (2) total depth (feet) 260
- (3) static water level (feet) 50 below top of ground
- (4) casing 4000 240
(material) (depth)
if telescope see back.
(size)
- (5) screen 20 240
(length) (depth to top)
4 PVC
(size) (material)
- (6) pump 1 14 Gpm
(HP) (yield gpm)
elect
(type power)
- (7) electric log
(yes or no)

RECEIVED

JUN 28 1993


- (8) how well bottom plugged Sand
SHARK

Dept. of Environmental Quality
Office of Land & Water Resources

DRILLERS REMARKS: good well

If well telescopes please sketch and show depths.

GROUND LEVEL

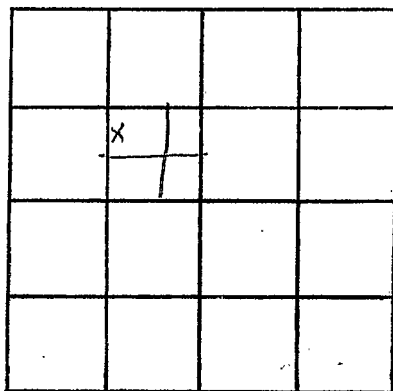

SECTION 21

Please indicate well location X.

ADDITIONAL INFORMATION

If more than one screen,
show locations of each on sketch.