

MISSISSIPPI DEPARTMENT OF NATURAL RESOURCES

Bureau of Land and Water Resources

Southport Mall

P.O. Box 10631

Jackson, Mississippi 39209

WATER WELL DRILLERS LOG

Marion
K 2093

4-30 19 93 Hollinger Well Marion
date well completed firm name county well located

LANDOWNER: Jimmy Mc Nabbs
RT 2
Foxworth, MS 39483
(mailing address)

description of formations encountered	from to	
<u>Chalk</u>	<u>0</u>	<u>20</u>
<u>Chalk, sand</u>	<u>20</u>	<u>40</u>
<u>gravel, sand</u>	<u>40</u>	<u>80</u>


WELL LOCATION:
sec. 7 T. 3 (N) S. R. 13 (E) W.
1/2 miles SE of Foxworth
(distance) (direction) (nearest town)

WELL PURPOSE: camp
(home, irrigation, municipal, industrial)

WELL COMPLETION DATA:

- (1) diameter (inches) 2
- (2) total depth (feet) 80
- (3) static water level (feet) 10 below above top of ground.
- (4) casing PVC 80
(material) (depth)
(size) if telescope see back.
- (5) screen 10 70
(length) (depth to top)
2 PVC
(size) (material)
- (6) pump 1/2 7
(HP) (yield gpm)
elect
(type power)
- (7) electric log _____
(yes or no)
(organization running log)
- (8) how well bottom plugged sand
SHARK

DRILLERS REMARKS: Very good well

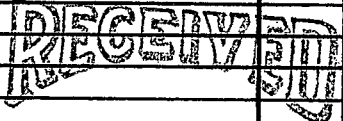


JUN 28 1993

Dept. of Environmental Quality
Office of Land & Water Resources

If well telescopes please sketch and show depths.

GROUND LEVEL

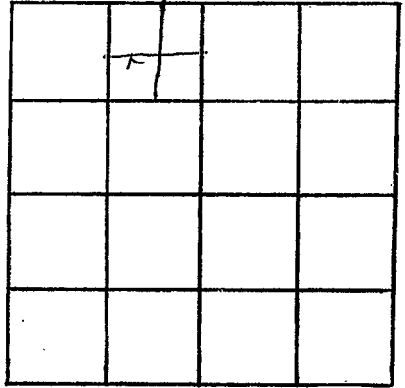

SECTION 7

Please indicate well location X.

ADDITIONAL INFORMATION

If more than one screen, show locations of each on sketch.