

MISSISSIPPI DEPARTMENT OF NATURAL RESOURCES

Bureau of Land and Water Resources

Southport Mall

P.O. Box 10631

Jackson, Mississippi 39209

WATER WELL DRILLERS LOG

MARION
K 2094

6-9
date well completed

1994 Hallinger Well Service Marion
firm name county well located

LANDOWNER: E W Rowley
Rt 1
Foxworth, Ms 39423
(mailing address)

description of formations encountered

from to

Sand 0-200
SAND & GRAVEL 200-250

WELL LOCATION:

sec. 12 T. 3 N R. 13 E
S W
8 miles W of Foxworth
(distance) (direction) (nearest town)

WELL PURPOSE:


(home, irrigation, municipal, industrial)

WELL COMPLETION DATA:

- (1) diameter (inches) 4"
- (2) total depth (feet) 250
- (3) static water level (feet) 90 below top of ground
- (4) casing PVC 240 (material) (depth)
- (size) if telescope see back.
- (5) screen 10 240 (length) (depth to top)
- 4" PVC (size) (material)
- (6) pump 1 10 (HP) (yield gpm)
- elect (type power)
- (7) electric log (yes or no)

(organization running log)

(8) how well bottom plugged Sand SH Ark

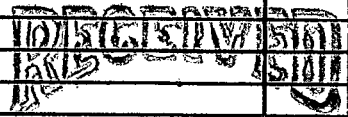


JUL 27 1994

DRILLERS REMARKS: Very good well

Dept. of Environmental Quality
Office of Land & Water Resources

If well telescopes please sketch and show depths.

GROUND LEVEL

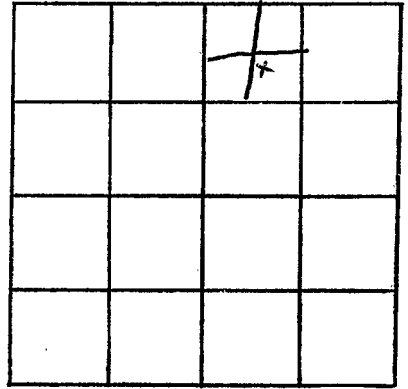

SECTION 12

Please indicate well location X.

ADDITIONAL INFORMATION

If more than one screen,
show locations of each on sketch.