

MISSISSIPPI DEPARTMENT OF ENVIRONMENTAL QUALITY
Bureau of Land and Water Resources

P. O. Box 10631
Jackson, MS 39289-0631
WATER WELL DRILLERS LOG

COUNTY WELL LOCATED Marion	
WELL NUMBER K 2095	CODED
DATE WELL COMPLETED 5/31/95	

PERMIT NUMBER 0-508
NAME OF DRILLING FIRM Jordan Well Ser

NAME & MAILING ADDRESS OF LANDOWNER Toxie Terrell Forworth, Miss			
WELL LOCATION:	SEC 4	TOWNSHIP 3	RANGE N 13 E
DISTANCE 5 Miles	DIRECTION SSW	NEAREST TOWN of Forworth	
OTHER LANDMARK			
WELL PURPOSE <input checked="" type="checkbox"/> Home Irrigation, Municipal, Industrial, Fish Pond, etc.			

PUMP DATA		
PUMP TYPE (Circle One): <input checked="" type="checkbox"/> Submersible Turbine, Jet, Flowing Well, Other (Describe) _____		
POWER TYPE (Circle One): <input checked="" type="checkbox"/> Electric, Tractor, Diesel, Gasoline, Butane, Other (Describe) _____ H/P _____		
Pump Capacity (GPM) 10	No. of Stages 15	Setting Depth 137 FT.
PUMP TEST		
Well yielded _____ GPM with a drawdown of _____ ft. after _____ hours of pumping		


WELL DATA		
Well Depth 147	Casing Diameter (In.) 4	Casing Length (Ft.) 137
Type of Casing Pvc	Hole Depth 147	Depth to Static Water Level 85
TYPE OF COMPLETION: (Circle One or More): Gravel Packed, Underreamed, Telescoped, Natural Development, Open Hole, Other (Describe) 10th cement Grout		
Top of Lap Pipe or Reduction in Casing		
FEET <input type="checkbox"/> IF TELESCOPED OR MORE THAN ONE SCREEN: USE BACK PAGE		

LOG DATA	
TYPE OF LOG RUN (Circle One): No Log Run, Electric, Gamma Ray, Density, Sonic, Neutron, Other (Describe) _____	
Name of Organization Running Log	

SCREEN DATA		
Diameter - Inches 4	Length - Feet 10	Slot Size - Inches .012
Screen Type POC	Depth to Bottom - Feet 137	


GEOLOGIC DATA (Office Use Only)			
Surface Elev.	Geologic Unit	Unit Thickness	Depth to Top
Subs. SWL	Date	Analysis	Aquifer Test

Driller's Remarks

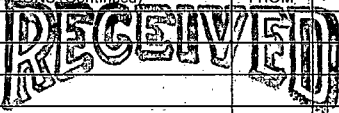DESCRIPTION OF FORMATIONS ENCOUNTERED	FROM	TO	FORMATIONS (Continued)	FROM	TO
Top Soil	0	1	 JUN 14 1995 Environmental Quality Office of Land & Water Resources		
SANDY CLAY	1	55			
SAND	55	75			
Gravel	75	90			
SAND	90	147			
			IF MORE SPACE IS NEEDED, USE BACK		

If well telescopes please
sketch and show depths.

GROUND LEVEL

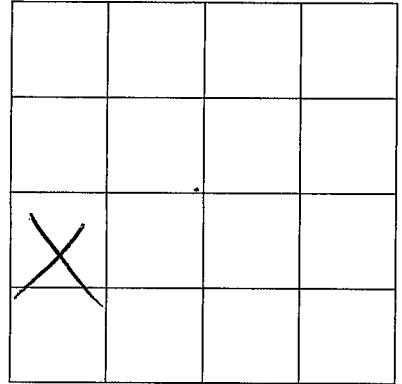

SECTION 3

Please indicate well location X.

ADDITIONAL INFORMATION

If more than one screen,
show location of each on sketch.