




If well telescopes please  
sketch and show depths.

GROUND LEVEL

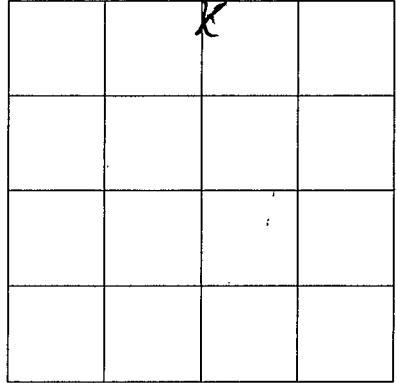

SECTION 21

Please indicate well location X.

ADDITIONAL INFORMATION

Lined area for additional information.

If more than one screen,  
show location of each on sketch.