

MISSISSIPPI DEPARTMENT OF ENVIRONMENTAL QUALITY

Office of Land and Water Resources

P. O. Box 10631
Jackson, MS 39289-0631
WATER WELL DRILLERS LOG

COUNTY WELL LOCATED <i>Monroe</i>	
WELL NUMBER <i>K 2104</i>	CODED
DATE WELL COMPLETED <i>9-2-97</i>	

PERMIT NUMBER <i>0-586</i>
NAME OF DRILLING FIRM <i>James Wells</i>
<i>Water Well Service</i>

NAME & MAILING ADDRESS OF LANDOWNER <i>Raymond Rowell (STORE)</i>		
<i>2317 Hwy 35 South</i>		
<i>Foxworth, MS 39483</i>		
WELL LOCATION: SEC	TOWNSHIP	RANGE
<i>12</i>	<i>3 S</i>	<i>13 E</i>
DISTANCE	DIRECTION	NEAREST TOWN
<i>3</i> Miles	<i>South</i> of	<i>Foxworth</i>
OTHER LANDMARK <i>35 South</i>		
WELL PURPOSE (Home, Irrigation, Municipal, Industrial, Fish Pond, etc.) <i>STORE</i>		

PUMP DATA		
PUMP TYPE (Circle One): Submersible, Turbine, <input checked="" type="radio"/> Jet, Flowing Well, Other (Describe) _____		
POWER TYPE (Circle One): Electric, Tractor, Diesel, Gasoline, Butane, Other (Describe) _____ H/P <u>1</u>		
Pump Capacity (GPM)	No. of Stages	Setting Depth
		FT.
PUMP TEST		
Well yielded _____ <i>10</i> GPM with a drawdown of _____ ft. after _____ hours of pumping		

WELL DATA		
Well Depth <i>80</i>	Casing Diameter (In.) <i>2</i>	Casing Length (Ft.) <i>70</i>
Type of Casing <i>PVC</i>	Hole Depth <i>80</i>	Depth to Static Water Level <i>45</i>

LOG DATA	
TYPE OF LOG RUN (Circle One): No Log Run, Electric, Gamma Ray, Density, Sonic, Neutron, Other (Describe) _____	
Name of Organization Running Log	

TYPE OF COMPLETION: (Circle One or More):
 Gravel Packed Underreamed, Telescoped,
 Natural Development, Open Hole, Other
 (Describe) _____

WELL GROUTED TO A DEPTH OF *10* FEET
 Type Grout (circle one): Cement, Bentonite, or Mix

SCREEN DATA		
Diameter - Inches <i>2</i>	Length - Feet <i>10</i>	Slot Size - Inches <i>.010</i>
Screen Type <i>PVC SLOT</i>	Depth to Bottom - Feet <i>80 - 70</i>	


GEOLOGIC DATA (Office Use Only)			
Surface Elev.	Geologic Unit	Unit Thickness	Depth to Top
Subs. SWL	Date	Analysis	Aquifer Test
Driller's Remarks			
Top of Lap Pipe or Reduction in Casing <i>RCVD</i>			
FEET		IF TELESCOPED OR MORE THAN ONE SCREEN: USE BACK PAGE	

DESCRIPTION OF FORMATIONS ENCOUNTERED	FROM	TO	FORMATIONS (Continued)	FROM	TO
<i>Clay</i>	<i>0</i>	<i>15</i>			
<i>Sand Parting</i>	<i>15</i>	<i>80</i>			

IF MORE SPACE IS NEEDED, USE BACK

If well telescopes please
sketch and show depths.

GROUND LEVEL

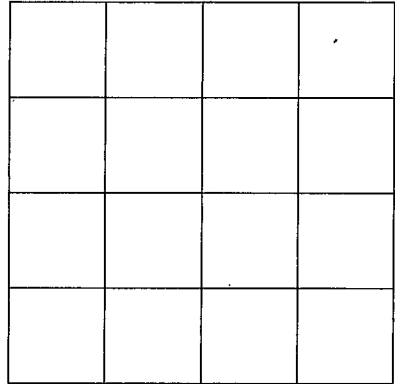

SECTION _____

Please indicate well location X.

ADDITIONAL INFORMATION

If more than one screen,
show location of each on sketch.