

**MISSISSIPPI DEPARTMENT OF ENVIRONMENTAL QUALITY**

Office of Land and Water Resources

P. O. Box 10631  
Jackson, MS 39289-0631  
**WATER WELL DRILLERS LOG**

COUNTY WELL LOCATED <u>Marion</u>	
WELL NUMBER <u>210</u>	CODED
DATE WELL COMPLETED <u>8-7-98</u>	

PERMIT NUMBER <u>0-586</u>
NAME OF DRILLING FIRM <u>James Wells</u>
<u>Water Well Ser</u>

NAME & MAILING ADDRESS OF LANDOWNER <u>CR2'N Customs</u>		
<u>2913 Hwy 35 South</u>		
<u>Foxworth, Ms. 39483</u>		
WELL LOCATION: SEC	TOWNSHIP	RANGE
<u>23</u>	<u>3</u>	<u>13</u>
	<u>N</u> S	<u>E</u> W
DISTANCE <u>3</u> Miles	DIRECTION <u>South</u>	NEAREST TOWN <u>Foxworth</u>
OTHER LANDMARK		
WELL PURPOSE <input checked="" type="checkbox"/> Home, Irrigation, Municipal, Industrial, Fish Pond, etc.		

PUMP DATA		
PUMP TYPE (Circle One): Submersible, Turbine, Jet, Flowing Well, Other (Describe) _____		
POWER TYPE (Circle One): Electric, Tractor, Diesel, Gasoline, Butane, Other (Describe) _____ H/P _____		
Pump Capacity (GPM)	No. of Stages	Setting Depth  FT.
PUMP TEST		
Well yielded _____ GPM with a drawdown of _____ ft. after _____ hours of pumping		

WELL DATA		
Well Depth <u>135 FT</u>	Casing Diameter (In.) <u>4 in</u>	Casing Length (Ft.) <u>115</u>
Type of Casing <u>PVC</u>	Hole Depth <u>135 FT</u>	Depth to Static Water Level <u>70</u>

LOG DATA	
TYPE OF LOG RUN (Circle One): Electric, Gamma Ray, Density, Sonic, Neutron, Other (Describe) _____	
Name of Organization Running Log	

TYPE OF COMPLETION: (Circle One or More):  
 Gravel Packed,     Underreamed,     Telescoped,  
 Natural Development,     Open Hole,     Other  
 (Describe) \_\_\_\_\_

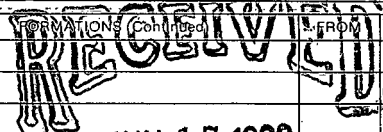
GEOLOGIC DATA (Office Use Only)			
Surface Elev.	Geologic Unit	Unit Thickness	Depth to Top
Subs. SWL	Date	Analysis	Aquifer Test

WELL GROUTED TO A DEPTH OF 15 FEET  
 Type Grout (circle one):  Cement,  Bentonite, or Mix

Driller's Remarks <u>Casings only</u>
Top of Lap Pipe or Reduction in Casing  FEET
IF TELESCOPED OR MORE THAN ONE SCREEN: USE BACK PAGE

SCREEN DATA		
Diameter - Inches <u>4 in</u>	Length - Feet <u>20</u>	Slot Size - Inches <u>08</u>
Screen Type <u>PVC slot</u>	Depth to Bottom - Feet <u>115-135</u>	

DESCRIPTION OF FORMATIONS ENCOUNTERED	FROM	TO
<u>Top Soil</u>	<u>0</u>	<u>2</u>
<u>Sandy Clay</u>	<u>2</u>	<u>15</u>
<u>Gray Clay</u>	<u>15</u>	<u>90</u>
<u>Sand</u>	<u>90</u>	<u>135</u>

  
**JUN 17 1999**  
 Dept of Environmental Quality  
 Office of Land & Water Resources  
 IF MORE SPACE IS NEEDED, USE BACK

