

MISSISSIPPI  
BOARD OF WATER COMMISSIONERS  
416 North State Street  
Jackson, Mississippi 39201

COPIED

WATER WELL DRILLERS LOG

MARION  
L 16  
1-69

DEC. 19 69 E. B. SHERRARD MARION  
date well completed firm name county well located

LANDOWNER:	description of formations encountered	from	to
MRS. BERTHA SINGLEY COLUMBIA, MISS. (mailing address)	RED CLAY SAND & GRAVEL RED HARD BASE CLAY ON BOTTOM	0	30 93
WELL LOCATION: sec. 1 T 3 N R 18 E 2 miles E of COLUMBIA (distance) (direction) (nearest town)			
WELL PURPOSE: (home) irrigation, municipal, industrial			
WELL COMPLETION DATA:			
(1) diameter (inches) 2"			
(2) total depth (feet) 93			
(3) static water level (feet) 52 below top of ground.			
(4) casing (material) (depth) 93			
2" if telescope see back. (size)			
(5) screen (length) (depth to top) 3'			
2 1/2" (size) (material) S.W.S.			
(6) pump (HP) (yield gpm) 9			
(type power)			
(7) electric log (yes or no)			
(organization running log)			
(8) how well bottom plugged			
DRILLERS REMARKS:			


COPIED

FEB 5 - 1970

MISSISSIPPI BOARD OF WATER COMMISSIONERS

If well telescopes please sketch and show depths.

GROUND LEVEL

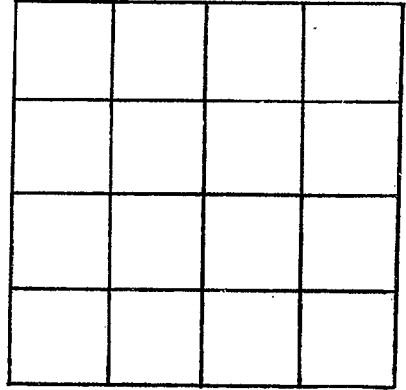

SECTION \_\_\_\_\_

Please indicate well location X.

ADDITIONAL INFORMATION

Lined area for additional information.

If more than one screen, show locations of each on sketch.