

MARION MISSISSIPPI BOARD OF WATER COMMISSIONERS

CODED

*H L 20*  
7-9-65

WATER WELL DRILLERS LOG

Date: 7-9, 1965, Driller: S S Newsom County Marion

(Name)

(1) Owner of Land: Newsom  
Pos Newsom  
(Name)  
Columbia City  
(Address)

(2) Location:  $\frac{1}{4}$ ,  $\frac{1}{4}$ , Sec. 4 3-18  
T R  
8 miles East, of Columbia  
(distance) (direction) (Nearest Town)

(3) Topography: Hilly  
(Hilly) (Flat) (Level)

(4) Purpose of Well: Domestic  
(Domestic Irrigation  
Municipal, Industrial, Other)

Description & Color of Materials  
Sand, Clay, Red Clay, Shell, etc.

Thick-  
ness  
Feet

Depth  
Feet

Red sand 20

White clay 80

Water sand 20

120

CODED

Information upon completion of well:

(1) Diameter 2 inches.

(2) Total Depth 120 feet.

(3) Water Level 90 feet below top of ground.

(4) Cased to 1.12, Size 2


(5) Screen: Size 2, Length 8

(6) Were any formations sealed against pollution?  
no

If YES depth of formation \_\_\_\_\_

Why \_\_\_\_\_

Drillers Remarks: \_\_\_\_\_

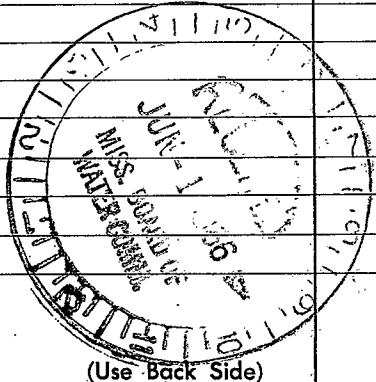

(Use Back Side)

Well No.

