

MARION  
 R L 21  
 1-1-63

MISSISSIPPI BOARD OF WATER COMMISSIONERS

WATER WELL DRILLERS LOG

CODED

Date: JAN. 1, 1963, Driller: E. B. SHERRARD County MARION

(Name)  
SHERPARD WELL SERVICE

- (1) Owner of Land: Reel and Rod Club  
 (Name)  
Columbia, Miss-  
 (Address)
- (2) Location: 8-3-18  $\frac{1}{4}$ ,  $\frac{1}{4}$ , Sec. T R  
1 miles W of COLUMBIA  
 (distance) (direction) (Nearest Town)
- (3) Topography:  (Hilly)  (Flat)  (Level)
- (4) Purpose of Well: CLUB USE  
 (Domestic Irrigation  
 Municipal, Industrial, Other)

Description & Color of Materials Sand, Clay, Red Clay, Shell, etc.	Thick- ness Feet	Depth Feet
GRAY CLAY		20
PEA GRAVEL		40
SAND		60
	1	80
BLUE CLAY	1	100
	1	120
CODED	1	140
WATER SAND	1	160
	1	180
	2	200
	2	220
	2	240
BLUE CLAY	2	260
	2	280
	3	300
	3	320
	3	340
	3	360
	3	380
	4	400
	4	420
	4	440
	4	460
	4	480
FLOW SAND	5	500
512	5	520


Information upon completion of well:

- (1) Diameter 2 1/2 inches.
- (2) Total Depth 512 feet.
- (3) Water level FLOW feet below top of ground.
- (4) Cased to \_\_\_\_\_, Size \_\_\_\_\_
- (5) Screen: Size \_\_\_\_\_, Length \_\_\_\_\_
- (6) Were any formations sealed against pollution?  
 \_\_\_\_\_ yes, \_\_\_\_\_ no.

If YES depth of formation \_\_\_\_\_

Why \_\_\_\_\_

Drillers Remarks: \_\_\_\_\_

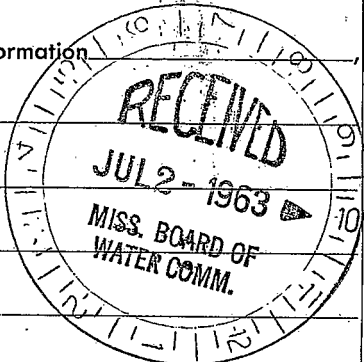

(Use Back Side)

Well No.

