

MS-1W-1550

CODED

Marion
L.A. 28
4-14-69
M.G.S.

MISSISSIPPI
BOARD OF WATER COMMISSIONERS
416 North State Street
Jackson, Mississippi 39201

CODED

WATER WELL DRILLERS LOG

4-14 1969 ERINER Drilling Service, Inc. MARION
date well completed firm name county well located

LANDOWNER: Hampton Water Ass'n.	description of formations encountered	from	to
Columbia, Miss. (mailing/address)	Top Soil	0	2
WELL LOCATION: sec. 14 T. 31N S. R. 18W 4 miles SE of Columbia (distance) (direction) (nearest town)	Sand	2	50'
WELL PURPOSE: MUNICIPAL (home, irrigation, municipal, industrial)	Clay	50	73
WELL COMPLETION DATA: (1) diameter (inches) 12" (2) total depth (feet) 195 (3) static water level (feet) 70' below above top of ground. (4) casing steel, 140' (material) (depth) 12" (size) if telescope see back. (5) screen 50', 145' (length) (depth to top) 6" Stainless Steel (size) (material) (6) pump 15 (HP) 300 (yield gpm) Electric (type power) (7) electric log Yes (yes or no) M.G.S. 10-15-68 (organization running log) (8) how well bottom plugged BACK WASH UAT 10	SAND & Gravel	73	195
DRILLERS REMARKS:			

CODED


CODED

APR 15 1969

RD. 05
WATER COMM.

If well telescopes please sketch and show depths.

GROUND LEVEL

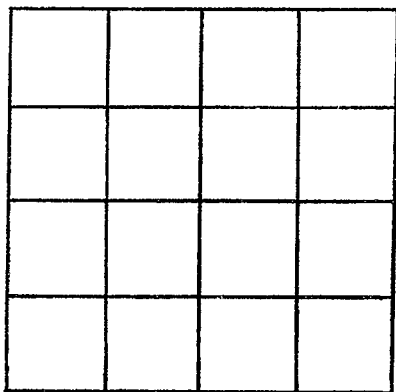

SECTION 14

Please indicate well location X.

ADDITIONAL INFORMATION

If more than one screen, show locations of each on sketch.