

MARION

L 32  
2-13-64

WATER WELL DRILLERS LOG

CODED

Date: 2-13-1964, Driller: Layne-Central Co. County Marion (Name)

(1) Owner of Land: City of Columbia (Name)

Columbia, Mississippi (Address)

(2) Location: 9 3-18 1/4, Sec. T R

miles of (distance) (direction) (Nearest Town)

(3) Topography: (Hilly) (Flat) (Level)

(4) Purpose of Well: Municipal (Domestic Irrigation, Municipal, Industrial, Other)

Description & Color of Materials Sand, Clay, Red Clay, Shell, etc.	Thick- ness Feet	Depth Feet
top soil	1	1
clay	11	12
coarse sand-gravel	13	25
clay	4	29
sand-gravel	63	92
coarse sand	35	127
sand, gravel & clay	10	137

Information upon completion of well:

(1) Diameter 24" inches.

(2) Total Depth 137' feet.

(3) Water Level 10' feet below top of ground.

(4) Cased to 52' 8", Size 24"

(5) Screen: Size 8", Length 50'

(6) Were any formations sealed against pollution?

X yes, no.


If YES depth of formation 52' 8"

Why required

Drillers Remarks:

CODED

Plugged and Abandoned  
by  
Gurmen  
6/8/66

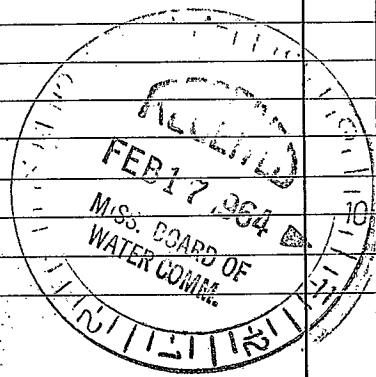

(Use Back Side)

Well No.

(F)