

L 33
4-6-66

WATER WELL DRILLERS LOG

Date: 4-6, 1966, Driller: E.B. SHEPPARD County Marion
(Name)

| (1) Owner of Land | Description & Color of Materials Sand, Clay, Red Clay, Shell, etc. | Thick- ness Feet | Depth Feet |
|--|---|------------------------|--------------------------|
| <u>George G. Westhoff</u> (Name) <u>Columbia, Miss.</u> (Address) | <u>HARD GRAY CLAY</u> | | <u>50'</u> |
| (2) Location: <u>1/4</u> , <u>1/4</u> , Sec. <u>8</u> T <u>31</u> R <u>18</u> <u>1</u> miles <u>E</u> , of <u>City limit</u> (distance) (direction) (Nearest Town) | <u>SANDY FINE COARSE WHITE SAND</u> | | <u>60'</u> <u>70'</u> |
| (3) Topography: <input checked="" type="checkbox"/> (Hilly) <input type="checkbox"/> (Flat) <input type="checkbox"/> (Level) | | | |
| (4) Purpose of Well: <u>DOMESTIC</u> (Domestic Irrigation Municipal, Industrial, Other) | | | |

Information upon completion of well:


- (1) Diameter 2 inches.
- (2) Total Depth 70 feet.
- (3) Water Level 40 feet below top of ground.
- (4) Cased to 70, Size 2"
- (5) Screen: Size 2", Length 3'
- (6) Were any formations sealed against pollution?
_____ yes, no.

If YES depth of formation _____

Why _____

Drillers Remarks: _____

CODED

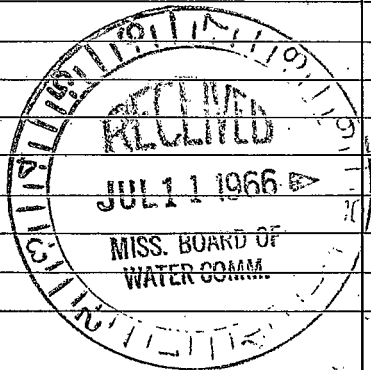

(Use Back Side)

Well No.

