

MARION
ML 35
9-15-62

MISSISSIPPI BOARD OF WATER COMMISSIONERS

WATER WELL DRILLERS LOG

CODED

Date: 9-15, 1962, Driller: E.B. SHEPARD County: MARION

(Name)

(1) Owner of Land:	Description & Color of Materials Sand, Clay, Red Clay, Shell, etc.	Thick- ness Feet	Depth Feet
ALLEN BOWMAN (Name)	GRAY CLAY		10
EDNA MISS (Address)	" "		20
25 3-18 (2) Location: 1/4, 1/4, Sec. T. R.	SAND		30
9 miles S.E. of COLUMBIA (distance) (direction) (Nearest Town)	BLUE CLAY		40
" "	" "		50
" "	" "		60
" "	" "		70
" "	" "		80
" "	" "		90
(4) Purpose of Well: DOMESTIC (Domestic Irrigation Municipal, Industrial, Other)	SAND STREAKS		100
	BLUE CLAY		110
	" "		120
	" "		130
	" "		140
	SAND		150
	SAND & GRAVEL		160


Information upon completion of well:

- (1) Diameter 2" inches.
- (2) Total Depth 160' feet.
- (3) Water Level 55' feet below top of ground.
- (4) Cased to 160', Size _____
- (5) Screen: Size 2", Length 5'
- (6) Were any formations sealed against pollution?
_____ yes, X no.

If YES depth of formation _____

Why _____

Drillers Remarks: _____

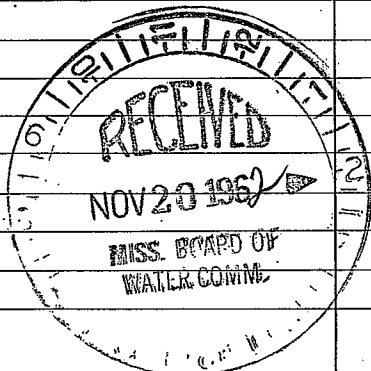

(Use Back Side)

Well No.

Handwritten text, likely bleed-through from the reverse side of the page. The text is extremely faint and illegible due to the quality of the scan. It appears to be organized into several paragraphs or sections, but the specific words and sentences cannot be discerned.