

MARION
L 39
1-11-71

MISSISSIPPI
BOARD OF WATER COMMISSIONERS
416 North State Street
Jackson, Mississippi 39201

CODED

WATER WELL DRILLERS LOG

7-11-71 date well completed Dean Linn's Well Service firm name MARION county well located

LANDOWNER:
Venton Adams
7
(mailing address)

WELL LOCATION:
sec. 5 T. 3 S. R. 18 E.
1 1/2 miles E of Columbia
(distance) (direction) (nearest town)

WELL PURPOSE: Home Use
(home, irrigation, municipal, industrial)

- WELL COMPLETION DATA:
- (1) diameter (inches) 4"
 - (2) total depth (feet) 120'
 - (3) static water level (feet) 60 below top of ground.
 - (4) casing Plastic, 110' (material) (depth)
 (size) if telescope see back.
 - (5) screen 10', 110' (length) (depth to top)
 4", Plastic (size) (material)
 - (6) pump 1/2 sub. (HP) (yield gpm)
 (type power)
 - (7) electric log (yes or no)
 (organization running log)
 - (8) how well bottom plugged

description of formations encountered	from	to
top soil	0	1
clay	1	60
Chalk	60	78
fine sand	78	95
Water sand	95	120

CODED


OCT 21 1971

DRILLERS REMARKS:

MISS. BD. OF
WATER COMM.

If well telescopes please sketch and show depths.

GROUND LEVEL

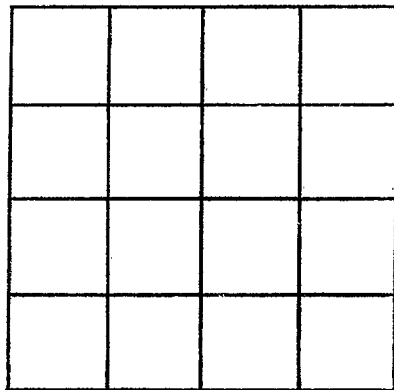

SECTION _____

Please indicate well location X.

ADDITIONAL INFORMATION

If more than one screen, show locations of each on sketch.