

MARION
L42
11-13-73

MISSISSIPPI
BOARD OF WATER COMMISSIONERS
416 North State Street
Jackson, Mississippi 39201

CODED

WATER WELL DRILLERS LOG

11/13 1973 Lucas-Lima Marion
date well completed firm name county well located

LANDOWNER:
Tommy Wallace
Columbus, Miss.
(mailing address)

description of formations encountered	from	to
<u>Top Soil</u>	<u>0</u>	<u>0.72</u>
<u>Clay</u>	<u>1.12</u>	<u>2.3</u>
<u>Chalk</u>	<u>2.3</u>	<u>6.1</u>
<u>Sand</u>	<u>6.1</u>	<u>11.0</u>

WELL LOCATION:
sec. 9 T. 3 N. R. 18 E
1 miles S of Columbus
(distance) (direction) (nearest town)

WELL PURPOSE: Vehicle Wash
(home, irrigation, municipal, industrial)

WELL COMPLETION DATA:

(1) diameter (inches) 4"

(2) total depth (feet) 110"

(3) static water level (feet) 12' above top of ground

(4) casing Plastic, 80'
(material) (depth)
 if telescope see back.
(size)

(5) screen 30', 80'
(length) (depth to top)
4", Plastic
(size) (material)

(6) pump 3 40
(HP) (yield gpm)
Elec
(type power)

(7) electric log NO
(yes or no)

(organization running log)

(8) how well bottom plugged B W Valve

CODED


DRILLERS REMARKS:

NOV 26 1973

MISS. BU
WATER

If well telescopes please
sketch and show depths.

GROUND LEVEL

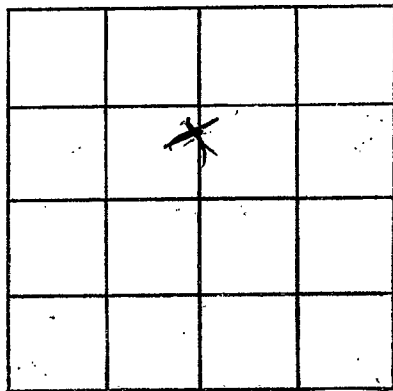

SECTION 9

Please indicate well location X.

ADDITIONAL INFORMATION

If more than one screen,
show locations of each on sketch.