

MARION  
L 43  
9/73

MISSISSIPPI  
BOARD OF WATER COMMISSIONERS  
416 North State Street  
Jackson, Mississippi 39201

CODED

WATER WELL DRILLERS LOG

Sept. 73 E.B. Sheward Marion  
date well completed firm name county well located

LANDOWNER:	description of formations encountered	from	to
Roy Roberts Columbia, Miss. (mailing address)	SAND & GRAVEL	0	60'
<b>WELL LOCATION:</b>			
sec 21 T 30 N R 12 E W 2 miles S Columbia (distance) (direction) (nearest town)			
<b>WELL PURPOSE:</b>			
(home irrigation, municipal, industrial)			
<b>WELL COMPLETION DATA:</b>			
(1) diameter (inches) 2"			
(2) total depth (feet) 60'			
(3) static water level (feet) 20' below above top of ground.			
(4) casing (material) pl. (depth) 55'			
2" (size) if telescope see back.			
(5) screen (length) 5' (depth to top)			
(6) pump (HP) 1/3 (material) pl. (yield gpm) 8			
(7) electric log (yes or no) <input checked="" type="checkbox"/>			
(organization running log)			
(8) how well bottom plugged BWV			
<b>DRILLERS REMARKS:</b>			
MAY 1 1974 MISSISSIPPI BOARD OF WATER COMMISSIONERS			


CODED

MAY 1 1974

MISSISSIPPI BOARD OF WATER COMMISSIONERS

If well telescopes please sketch and show depths.

GROUND LEVEL

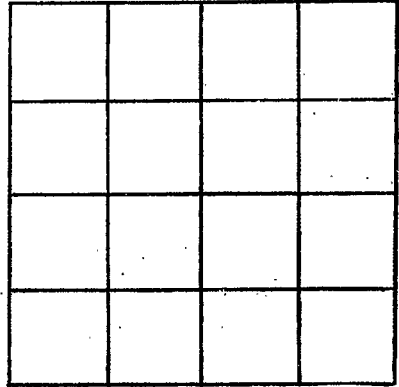

SECTION \_\_\_\_\_

Please indicate well location X.

ADDITIONAL INFORMATION

If more than one screen, show locations of each on sketch.