

MARION  
L 44  
12-11-73

MISSISSIPPI  
BOARD OF WATER COMMISSIONERS  
416 North State Street  
Jackson, Mississippi 39201

WATER WELL DRILLERS LOG

12 - 11 1973 GRINER - GINN Marion  
date well completed firm name county well located

LANDOWNER:  
Dixie Paving Co.  
P.O. Box 523 Columbus  
(mailing address) Miss.

WELL LOCATION:  
sec. 9 T. 30 S. R. 12 W.  
1 miles S of Columbus  
(distance) (direction) (nearest town)

WELL PURPOSE: office  
(home, irrigation, municipal, industrial)

- WELL COMPLETION DATA:
- (1) diameter (inches) 4"
  - (2) total depth (feet) 110
  - (3) static water level (feet) 12 below above top of ground.
  - (4) casing plastic, 100, 4" (material) (depth) (size) if telescope see back.
  - (5) screen 10', 100 (length) (depth to top) 4", plastic (size) (material)
  - (6) pump 3 30 (HP) (yield gpm) elec (type power)
  - (7) electric log NO (yes or no) NO (organization running log)
  - (8) how well bottom plugged B.W. Valve


description of formations encountered	from	to
Top Soil	0	3
Clay	3	9
Sand	9	79
Chalk	79	92
Sand	92	110

RECEIVED  
MAY 23 1974  
MISS. BOARD OF WATER COMMISSIONERS

DRILLERS REMARKS:

If well telescopes please sketch and show depths.

GROUND LEVEL

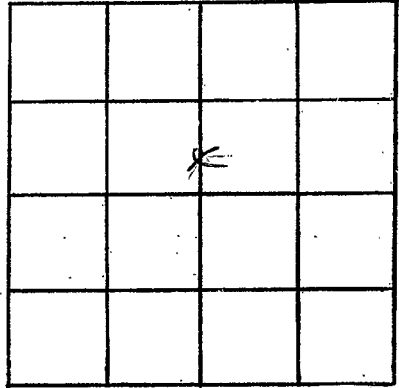

SECTION 9

Please indicate well location X.

ADDITIONAL INFORMATION

If more than one screen, show locations of each on sketch.