

L 47  
 Marion  
 4/10/75

MISSISSIPPI  
 BOARD OF WATER COMMISSIONERS  
 416 North State Street  
 Jackson, Mississippi 39201

CODED

WATER WELL DRILLERS LOG

~~4-10~~ 1975 Griner-Grinn Marion  
 date well completed firm name county well located

LANDOWNER:	description of formations encountered	from	to
<u>Deep Well Service</u>	<u>top soil</u>	0	1
<u>PO Box 12 Columbia</u> (mailing address)	<u>clay</u> <u>sand</u>	1	10
WELL LOCATION:			
sec. <u>9</u> T. <u>30</u> N. R. <u>16</u> <u>1</u> miles <u>S</u> of <u>Columbia</u> (distance) (direction) (nearest town)			
WELL PURPOSE: <u>industrial</u> (home, irrigation, municipal, industrial)			
WELL COMPLETION DATA:			
(1) diameter (inches) <u>4"</u>			
(2) total depth (feet) <u>105'</u>			
(3) static water level (feet) <u>55'</u> below top of ground.			
(4) casing <u>Plastic</u> <u>75'</u> (material) (depth)			
<u>4"</u> (size) if telescope see back.			
(5) screen <u>30'</u> <u>75'</u> (length) (depth to top)			
<u>4"</u> <u>Plastic</u> (size) (material)			
(6) pump <u>3'</u> (HP) (yield gpm)			
<u>Electric</u> (type power)			
(7) electric log <u>no</u> (yes or no)			
(organization running log)			
(8) how well bottom plugged <u>bw Valve</u>			
DRILLERS REMARKS:			


RECEIVED

JUN 6 1975

MISS. BOARD OF WATER COMMISSIONERS

If well telescopes please sketch and show depths.

GROUND LEVEL

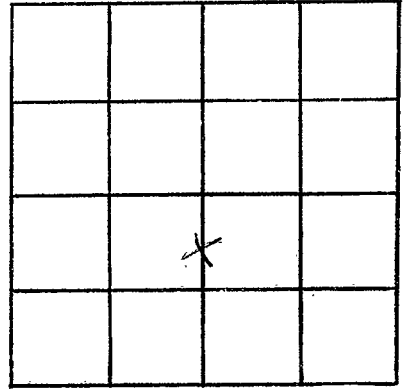

SECTION 8

Please indicate well location X.

ADDITIONAL INFORMATION

If more than one screen,  
show locations of each on sketch.