

RW-1549
 MARION
 252
 5179
 Elog #93

MISSISSIPPI
 BOARD OF WATER COMMISSIONERS
 416 North State Street
 Jackson, Mississippi 39201

CODED

WATER WELL DRILLERS LOG

MAY 19 79 GRINER DRILLING SER. MARION
 date well completed firm name county well located

LANDOWNER: LAMPTON
 WATER ASSOC., Well
 No. 2
 (mailing address)

description of formations encountered	from	to
Top soil	0	3
SANDY CLAY (Red)	3	21
SAND	21	42
CLAY	42	84
SAND & pec gravel	84	170
CLAY	170	230

WELL LOCATION: NE 1/4 SW 1/4 SW 1/4
 sec. 14 T 3 N R 18 E
 S W

WELL PURPOSE: Rural Water Assn
 (home, irrigation, municipal, industrial)

- WELL COMPLETION DATA:
- (1) diameter (inches) 10 3/4"
 - (2) total depth (feet) 192 ft.
 - (3) static water level (feet) _____ below/above top of ground.
 - (4) casing Steel 192
 (material) (depth)
10 3/4" If telescope see back.
 (size)
 - (5) screen 40 ft. 152
 (length) (depth to top)
8" 304 S.S. (010)
 (size) (material)
 - (6) pump 15 399
 (HP) (yield gpm)
Elect.
 (type power)
 - (7) electric log Yes
 (yes or no)
MGS
 (organization running log)
 - (8) how well bottom plugged BACK
WASH WAVE

Miss. Board of Water Comm.

MAY 21 1979


RECEIVED

DRILLERS REMARKS:

①

If well telescopes please sketch and show depths.

GROUND LEVEL

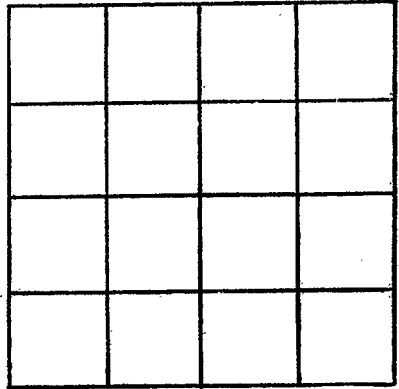

SECTION _____

Please indicate well location X.

ADDITIONAL INFORMATION

If more than one screen, show locations of each on sketch.