

MARION
L 53
8-10-79

MISSISSIPPI
BOARD OF WATER COMMISSIONERS
416 North State Street
Jackson, Mississippi 39201

CODED

WATER WELL DRILLERS LOG

8-10 1979 Griner Drilling Marion
date well completed firm name county well located

LANDOWNER:
FRONT Petroleum
P.O. Box 4096
Houma, La
(mailing address)

description of formations encountered	from	to
gravel & sand	0	210
chalk	210	276
pea gravel	276	378

WELL LOCATION: 2030' N + 2148' E
sec. 2 T 30 S R 18 E of
1 miles east of Columbia
(distance) (direction) (nearest town)

WELL PURPOSE: oil field supply
(home, irrigation, municipal, industrial)

CODED

WELL COMPLETION DATA:

- (1) diameter (inches) 4"
- (2) total depth (feet) 378'
- (3) static water level (feet) 85' Below top of ground.
- (4) casing steel 378'
(material) (depth)
4" if telescope see back.
(size)
- (5) screen 42' 336'
(length) (depth to top)
4" perforated
(size) (material)
- (6) pump AC 60
(HP) (yield gpm)
AC
(type power)
- (7) electric log
(yes or no)

(organization running log)

(8) how well bottom plugged orange peel

Miss. Board of Water Comm


SEP 17 1979

DRILLERS REMARKS:

RECEIVED

If well telescopes please sketch and show depths.

GROUND LEVEL

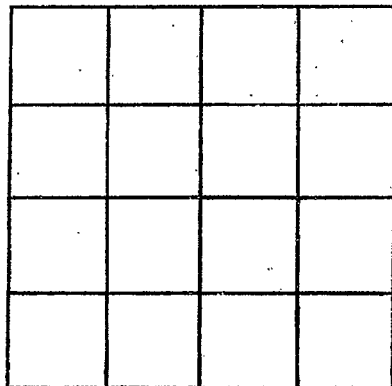

SECTION _____

Please indicate well location X.

ADDITIONAL INFORMATION

If more than one screen,
show locations of each on sketch.