

MARION
L 54
8-18-79

MISSISSIPPI
BOARD OF WATER COMMISSIONERS
416 North State Street
Jackson, Mississippi 39201

CODED


WATER WELL DRILLERS LOG

8-18-79 date well completed
Griner Drilling firm name
Marion county well located

LANDOWNER:	description of formations encountered	from	to
Hunt Petroleum P.O. Box 4096 Houma, La. 70361 (mailing address)	chalk - gravel gravel	0 21	21 357
WELL LOCATION: 2030' N + 248' E sec. 2 T-30 S R-18 E of 1 miles east of Columbia (distance) (direction) (nearest town)			
WELL PURPOSE: oil field supply (home, irrigation, municipal, industrial)			
WELL COMPLETION DATA:			
(1) diameter (inches) 3"	CODED		
(2) total depth (feet) 357'			
(3) static water level (feet) 85' below top of ground.			
(4) casing steel 342' (material) (depth)			
3" (size) if telescope see back:			
(5) screen 42' 300' (length) (depth to top)			
3" perforated (size) (material)			
(6) pump 70 (HP) (yield gpm) AC (type power)			
(7) electric log (yes or no)			
(organization running log) Orange			
(8) how well bottom plugged peep			
DRILLERS REMARKS:	Miss. Board of Water Comm. SEP 17 1979 RECEIVED		

If well telescopes please sketch and show depths.

GROUND LEVEL

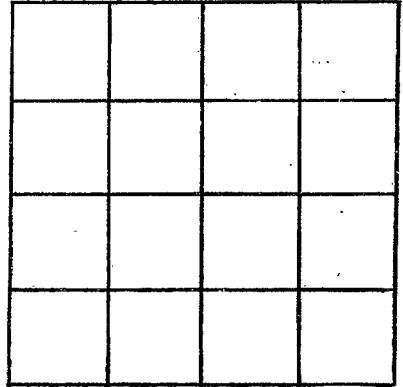

SECTION _____

Please indicate well location X.

ADDITIONAL INFORMATION

If more than one screen, show locations of each on sketch.