

MARION
L55
11/15/84

MISSISSIPPI DEPARTMENT OF NATURAL RESOURCES
Bureau of Land and Water Resources
Southport Mall
P.O. Box 10631
Jackson, Mississippi 39209
WATER WELL DRILLERS LOG

CODED

11/15/1984 date well completed Alsay Incorporated firm name Marion county well located

LANDOWNER:	description of formations encountered	from	to
Hub Water Assoc. Rt. 5, Box 103 Columbia, Ms. 39429 (mailing address)	Surface	0	6
	Brown Clay	6	9
	Red Sandy Clay	9	15
	Tan Sand	15	21
	Tan Sand w/wh. line mark.	21	27
	Brn. Clay strks. sand	27	50
	Gravel	50	57
	Blue Clay hard	57	134
	Blue Clay gummy	134	143
	Blue Clay hard, brn	143	189
	Blue Clay, gravel	189	217
	Sand	217	221
	Blue Clay	221	451
	Blue & Brn Clay, w/ Gravel	451	513
	Blue Clay, Sand	513	571
	Sand w/gravel	571	621
	Blue Clay	621	625
	Sand	625	685
	Blue Clay	685	690
	Hard Sand w/gravel	690	732
	Gravel & Hard Clay	732	738
	Soft brn & blue clay	738	813
	Sand	813	825
	Blue clay & soft Gravel	825	925
	Blue Clay & hard Gravel	925	946
	Sandy clay	946	980
	Fine Sand	980	1018
	Sandy, clay	1018	1027
	Sand	1027	1029
	Clay	1029	1030
	Sand	1030	1036
	Clay	1036	1075

LANDOWNER: Hub Water Assoc.

Rt. 5, Box 103

Columbia, Ms. 39429
(mailing address)

WELL LOCATION:

sec. 35 T-3 N R-14 E
S W

5 miles South of Columbia
(distance) (direction) (nearest town)

WELL PURPOSE: Municipal
(home, irrigation, municipal, industrial)

WELL COMPLETION DATA:

(1) diameter (inches) 10" x 5"

(2) total depth (feet) 1030'

(3) static water level (feet) 42' below top of ground.

(4) casing steel 950' (material) (depth)
10" (size) if telescope see back.

(5) screen 50' 970" (length) (depth to top)
5" 304 Stainless (size) wire (material) wound

(6) pump 30 280 (HP) (yield gpm)
Electric Motor (type power)

(7) electric log Yes (yes or no)

Miss. Bureau of Geology (organization running log)



(8) how well bottom plugged Cement and Back-Pressure Valve

DRILLERS REMARKS:

DEC - 7 1984

RECEIVED

If well telescopes please sketch and show depths.

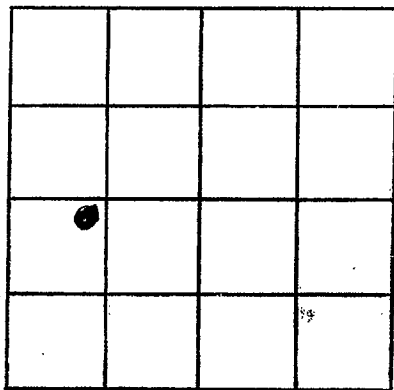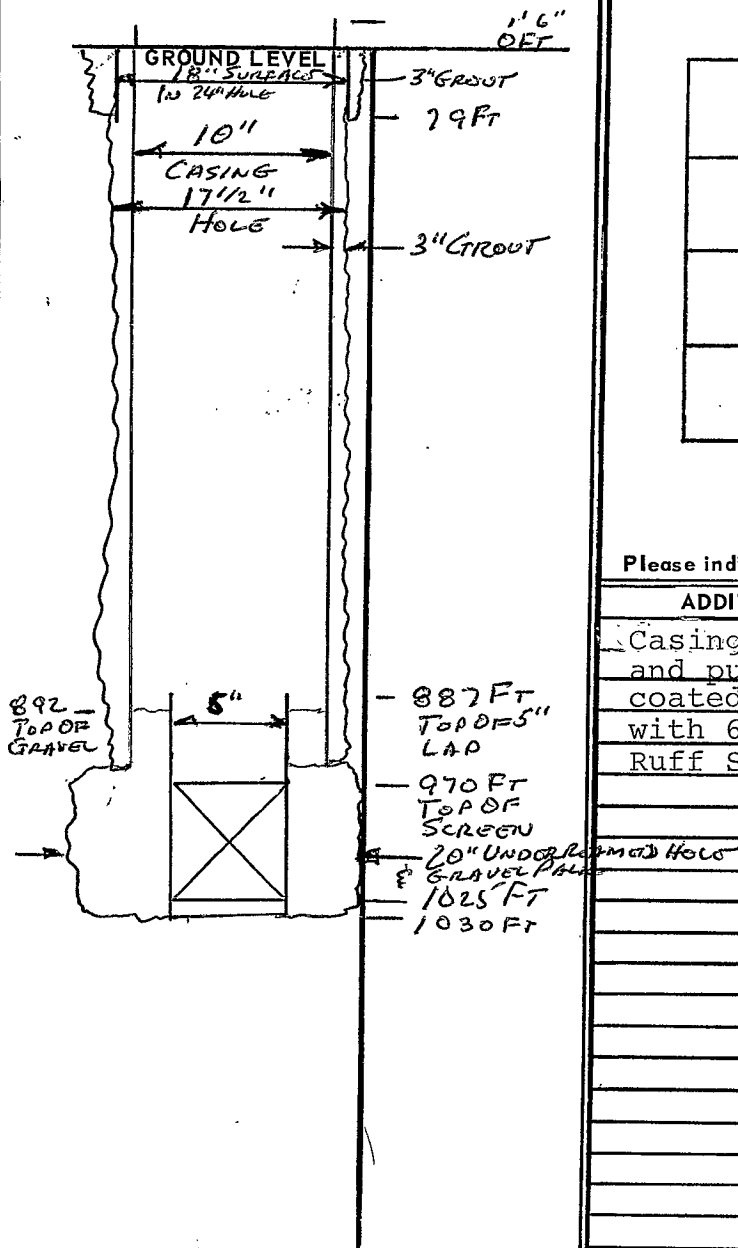

SECTION 35

Please indicate well location X.

ADDITIONAL INFORMATION

Casing I. D. and lap pipe and pump discharge column coated I. D. and O. D. with 6 Mils of Indurall Ruff Stuff.

If more than one screen, show locations of each on sketch.