

Marion
L 63
9-1-87

MISSISSIPPI DEPARTMENT OF NATURAL RESOURCES

Bureau of Land and Water Resources

Southport Mall

P.O. Box 10631

Jackson, Mississippi 39209

WATER WELL DRILLERS LOG

✓
CODED

9/1/87
 date well completed

Tom Griffith Water Well
 firm name

Marion
 county well located

LANDOWNER: SIMMONS OIL
1447 98 Bypass
~~High School Ave~~
Columbia, Ms. 39429
 (mailing address)

description of formations encountered

from

to

Saw Dust
Gravel
Sand

1 10
10 30
30 120

WELL LOCATION:

sec. 4 T 3 N R 18 E
City limits of Columbia
 (distance) miles (direction) of (nearest town)

WELL PURPOSE: Heat Pump
 (home, irrigation, municipal, industrial)

WELL COMPLETION DATA:

- (1) diameter (inches) 4"
- (2) total depth (feet) 120'
- (3) static water level (feet) 5' below above top of ground.
- (4) casing PVC 100
 (material) (depth)
- n/a (size) if telescope see back.
- (5) screen 20' 100
 (length) (depth to top)
4" PVC
 (size) (material)
- (6) pump air 100
 (HP) (yield gpm)
diesel
 (type power)
- (7) electric log No
 (yes or no)
N/A
 (organization running log)
- (8) how well bottom plugged BWD

CODED

RECEIVED


SEP 28 1987

Dept. of Natural Resources
 Bureau of Land & Water Resources

DRILLERS REMARKS:

If well telescopes please sketch and show depths.

GROUND LEVEL

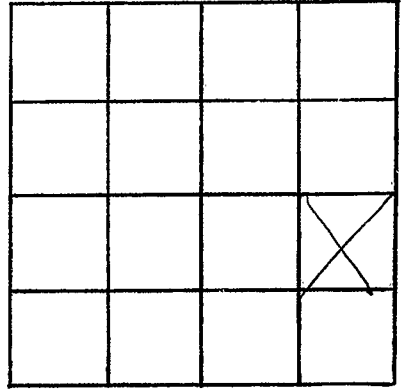

SECTION 4

Please indicate well location X.

ADDITIONAL INFORMATION

If more than one screen,
show locations of each on sketch.