

MISSISSIPPI DEPARTMENT OF NATURAL RESOURCES

Bureau of Land and Water Resources

Southport Mall

P.O. Box 10631

Jackson, Mississippi 39209

WATER WELL DRILLERS LOG

Marion
L 64
9-17-87

Weld

9-17-87
 date well completed

19 87 Hollinger
 firm name

Marion
 county well located

LANDOWNER: Rynals Butane
Carrie Rynals Whitehead
Hwy 13
Columbia, Miss.
 (mailing address)

description of formations encountered

from to

| | | |
|---------------------|-----|-----|
| CHALK, SAND, GRAVEL | 0 | 50 |
| CHALK | 50 | 150 |
| SAND | 150 | 200 |
| CHALK | 200 | 450 |
| COARSE SAND, GRAVEL | 450 | 520 |

WELL LOCATION:

sec. 22 T. 3 (N) R. 18 E
5 miles S of Columbia
 (distance) (direction) (nearest town)

WELL PURPOSE: ATYSH
 (home, irrigation, municipal, industrial)

WELL COMPLETION DATA:

- (1) diameter (inches) 2
- (2) total depth (feet) 520
- (3) static water level (feet) flow below above top of ground.
- (4) casing pvc 500
 (material) (depth)
 (size) if telescope see back.
- (5) screen 20 520
 (length) (depth to top)
2 pvc
 (size) (material)
- (6) pump NONE 40
 (HP) (yield gpm)
 (type power)
- (7) electric log (yes or no)
- (organization running log)

RECEIVED
 DEC 11 1987


Department of Natural Resources
 Bureau of Land & Water Resources

(8) how well bottom plugged

DRILLERS REMARKS: Very
Good flow well

If well telescopes please sketch and show depths.

GROUND LEVEL

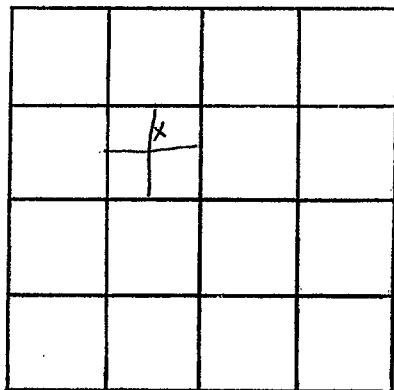

SECTION 22

Please indicate well location X.

ADDITIONAL INFORMATION

If more than one screen,
show locations of each on sketch.