

Marion
 L 2000
 5/20/79

MISSISSIPPI
 BOARD OF WATER COMMISSIONERS
 416 North State Street
 Jackson, Mississippi 39201

WATER WELL DRILLERS LOG

5/20 1979 Hollinsworth Marion
 date well completed firm name county well located

LANDOWNER: Morris S Faust Rt 2	description of formations encountered	from	to
Foxworth, Ms (mailing address)			

WELL LOCATION:
 sec. 34 T. 3 N. R. 18 E. W. 5
 4 miles N of James town
 (distance) (direction) (nearest town)

WELL PURPOSE: Home
 (home, irrigation, municipal, industrial)

- WELL COMPLETION DATA:
- (1) diameter (inches) 2"
 - (2) total depth (feet) 79
 - (3) static water level (feet) 50 below above top of ground.
 - (4) casing PVC (material), (depth) (size) If telescope see back.
 - (5) screen 5 (length), 52 (depth to top), 2" (size), PVC (material)
 - (6) pump 1 (HP), 7 (yield gpm), elect (type power)
 - (7) electric log (yes or no)

(organization running log)

(8) how well bottom plugged sand shale

DRILLERS REMARKS: good well


Miss. Board of Water Comm.

JUL 26 1979

RECEIVED

If well telescopes please sketch and show depths.

GROUND LEVEL

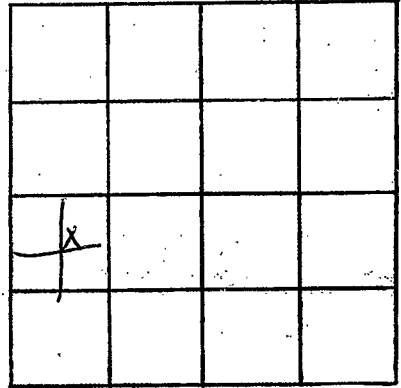

SECTION 34

Please indicate well location X.

ADDITIONAL INFORMATION

If more than one screen, show locations of each on sketch.