

MARION

L 2007

11-09-78

MISSISSIPPI BOARD OF WATER COMMISSIONERS 416 North State Street Jackson, Mississippi 39201

WATER WELL DRILLERS LOG

11/9/78 date well completed 1978 Hollinger Well Service firm name Marion county well located

LANDOWNER: Sebe Singley Sumberton Rd Columbia Ms. 39429 (mailing address)


Table with 3 columns: description of formations encountered, from, to. Entries include CHALK, gravel, sand, sand, and pea gravel.

WELL LOCATION: sec. 21 T-3 N R 18 E City limits of Columbia (distance) miles (direction) (nearest town)

WELL PURPOSE: STORE (home, irrigation, municipal, industrial)


- WELL COMPLETION DATA: (1) diameter (inches) 4" (2) total depth (feet) 70 (3) static water level (feet) 8 below top of ground. (4) casing PVC, 60 (material) (depth) (size) if telescope see back. (5) screen 10, 60 (length) (depth to top) (size) PVC (material) (6) pump 1, 20 (HP) (yield gpm) elect. (type power) (7) electric log (yes or no) (organization running log)

(8) how well bottom plugged sand SHARK DRILLERS REMARKS: Good well

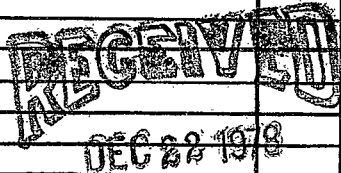

If well telescopes please sketch and show depths.

GROUND LEVEL

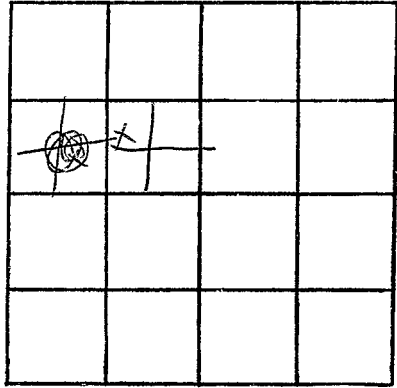

SECTION 21

Please indicate well location X.

ADDITIONAL INFORMATION

If more than one screen,
show locations of each on sketch.