

MARION
L 2002
12-20-78

**MISSISSIPPI
BOARD OF WATER COMMISSIONERS**
416 North State Street
Jackson, Mississippi 39201

WATER WELL DRILLERS LOG

12/20 19 78 Hollings Well Service Marion
 date well completed firm name county well located

LANDOWNER: James Eyrson
Rt 5
Columbia MS.
 (mailing address)

description of formations encountered	from to	
	ft	ft
<u>1/4" chert</u>	<u>0</u>	<u>10</u>
<u>sand gravel</u>	<u>10</u>	<u>60</u>

WELL LOCATION:
 sec. 20 T-3 (N) R-18 (E)
4 miles W of Columbia
 (distance) (direction) (nearest town)

WELL PURPOSE: Home
 (home, irrigation, municipal, industrial)

WELL COMPLETION DATA:

(1) diameter (inches) 2"

(2) total depth (feet) 60

(3) static water level (feet) 8 below above top of ground.

(4) casing PVC, 55,
 (material) (depth)
 (size) if telescope see back.

(5) screen 5, 55
 (length) (depth to top)
2, PVC
 (size) (material)

(6) pump 1/2, 6
 (HP) (yield gpm)
elect
 (type power)

(7) electric log _____
 (yes or no)

(organization running log)

(8) how well bottom plugged sand
SHARK

DRILLERS REMARKS: Good Well


Miss. Board of Water Comm.

MAR 6 - 1979

RECEIVED

If well telescopes please sketch and show depths.

GROUND LEVEL

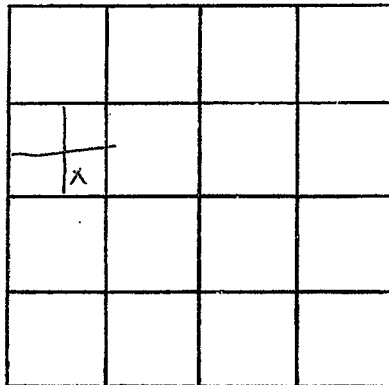

SECTION 20

Please indicate well location X.

ADDITIONAL INFORMATION

If more than one screen,
show locations of each on sketch.