

MARION
 L 2003
 12/29/77

MISSISSIPPI
 BOARD OF WATER COMMISSIONERS
 416 North State Street
 Jackson, Mississippi 39201

WATER WELL DRILLERS LOG

12/29 1977 Hollingers MARION
 date well completed firm name county well located

LANDOWNER: Daniel R. Ford
 RT5
 Columbin Ms
 (mailing address)

description of formations encountered	from	to
Chalk	0	20
Sand, GRAVEL	20	200
Chalk	200	400
Sand, GRAVEL	400	550

WELL LOCATION:
 sec. 22 T 3 N R 18 E
 1 miles S of Columbin
 (distance) (direction) (nearest town)

WELL PURPOSE: PASTURE
 (home, irrigation/municipal, industrial)

WELL COMPLETION DATA:

(1) diameter (inches) 2"
 (2) total depth (feet) 550
 (3) static water level (feet) 1/2 below above top of ground.
 (4) casing PVC 510
 (material) (depth)
 (size) if telescope see back.
 (5) screen 40 510
 (length) (depth to top)
 2 PVC
 (size) (material)
 (6) pump NO pump Flow good
 (HP) (yield gpm)
 NONE
 (type power)
 (7) electric log (yes or no)
 (organization running log)

(8) how well bottom plugged: SAND SHARK


DRILLERS REMARKS: 2" flow

RECEIVED
 FEB 10 1978

MISS. BD. OF WATER COMM

If well telescopes please sketch and show depths.

GROUND LEVEL

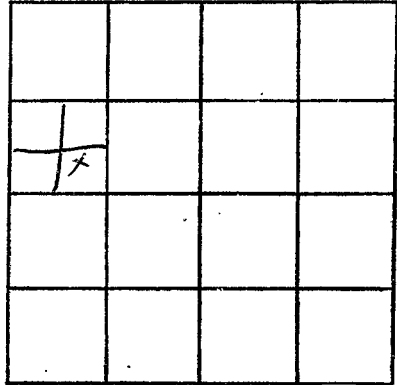

SECTION 22

Please indicate well location X.

ADDITIONAL INFORMATION

If more than one screen,
show locations of each on sketch.