

MARION

L 2004

9-16-78

MISSISSIPPI BOARD OF WATER COMMISSIONERS 416 North State Street Jackson, Mississippi 39201

WATER WELL DRILLERS LOG TOM GRIFFITH

PLUMBING & WELL SERVICE, INC.

320 MAIN ST. COLUMBIA, MS 39429

Marion county well located

9-16-19 date well completed

LANDOWNER:

Mrs. Marilyn Powell Rt. 2 Box 308 - Columbia, Miss. (mailing address)

description of formations encountered

from to

Topsoil	0	2
Clay	2	17
Gravel	17	48
Sand	48	64
Clay	64	79
Sand	79	130

WELL LOCATION:

sec. 22 T 3 N R 18 E 8 miles S of Columbia (distance) (direction) (nearest town)

WELL PURPOSE: Home (home, irrigation, municipal, industrial)

WELL COMPLETION DATA:

- (1) diameter (inches) 4"
- (2) total depth (feet) 130 ft.
- (3) static water level (feet) 90 ft. below top of ground.
- (4) casing plastic, 110 ft (material) (depth) 4" (size) if telescope see back.
- (5) screen 20 ft. 110 ft (length) (depth to top) 4" (size) plastic (material)
- (6) pump 110 ft. 10 (HP) (yield gpm) Electric (type power)
- (7) electric log no. (yes or no)

(organization running log)

(8) how well bottom plugged Back Wash Valve


DRILLERS REMARKS:

RECEIVED NOV - 3 1978

MISS. Bd. OF WATER COMMISSIONERS

If well telescopes please sketch and show depths.

GROUND LEVEL

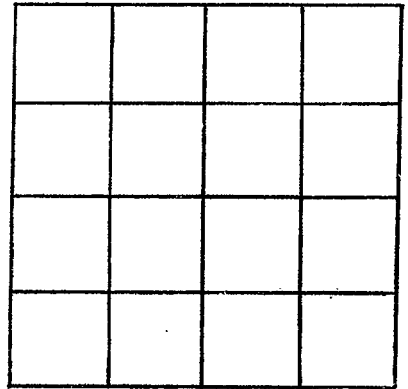

SECTION \_\_\_\_\_

Please indicate well location X.

ADDITIONAL INFORMATION

If more than one screen, show locations of each on sketch.