

MARION

L 2005

12/8/77

MISSISSIPPI  
BOARD OF WATER COMMISSIONERS  
416 North State Street  
Jackson, Mississippi 39201

WATER WELL DRILLERS LOG

12/8  
date well completed

1977 Hollings  
firm name

MARION  
county well located

LANDOWNER: Paul McGowan  
RT 2

Forworth, Ms.  
(mailing address)

WELL LOCATION:  
sec. 36 T 30 N R 18 E  
S W  
\_\_\_\_\_ miles AT of James town  
(distance) (direction) (nearest town)

WELL PURPOSE: Home  
(home, irrigation, municipal, industrial)

WELL COMPLETION DATA:

(1) diameter (inches) 2"

(2) total depth (feet) 127

(3) static water level (feet) 80 (below/above top of ground)

(4) casing pvc, 122  
(material) (depth)

(size) \_\_\_\_\_ if telescope see back.

(5) screen 5, 122  
(length) (depth to top)

2", pvc  
(size) (material)

(6) pump 1, 13  
(HP) (yield gpm)

elect  
(type power)

(7) electric log \_\_\_\_\_  
(yes or no)

\_\_\_\_\_  
(organization running log)

(8) how well bottom plugged Sand  
STARIC

DRILLERS REMARKS: good well

description of formations encountered	from	to
<u>Chalk, sand, gravel</u>	<u>0</u>	<u>80</u>
<u>sand, part gravel</u>	<u>80</u>	<u>127</u>


RECEIVED

FEB 10 1978

MISS. BD. OF WATER COMMISSIONERS

If well telescopes please sketch and show depths.

GROUND LEVEL

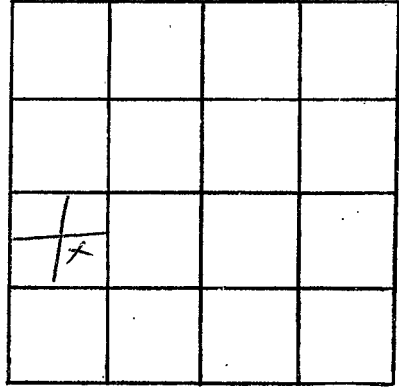

SECTION 36

Please indicate well location X.

ADDITIONAL INFORMATION

Lined area for additional information.

If more than one screen, show locations of each on sketch.