

Marion
L 2006
6/13/77

MISSISSIPPI
BOARD OF WATER COMMISSIONERS
416 North State Street
Jackson, Mississippi 39201

WATER WELL DRILLERS LOG

6/13 1977 Hollinsworth Marion
date well completed firm name county well located

LANDOWNER: Wiley Miller
Rt 7 Box 113
Columbia Miss
(mailing address)

description of formations encountered	from	to
Sand, gravel	0	15
SHARK	15	40
Sand	40	80

WELL LOCATION:
sec. 4 T. 3(N) S. R. 18 E
1/2 miles N of Columbia
(distance) (direction) (nearest town)

WELL PURPOSE: Home
(home, irrigation, municipal, industrial)

WELL COMPLETION DATA:

(1) diameter (inches) 2"

(2) total depth (feet) 80

(3) static water level (feet) 50 below above top of ground.

(4) casing PVC 75
(material) (depth)
(size) If telescope see back.

(5) screen 5 75
(length) (depth to top)
2" PVC
(size) (material)

(6) pump 1/2 6
(HP) (yield gpm)
elect
(type power)

(7) electric log _____
(yes or no)
(organization running log)

(8) how well bottom plugged SAND SHARK


DRILLERS REMARKS: very good

RECEIVED
JUL 11 1977

MISS. BD. OF WATER

If well telescopes please sketch and show depths.

GROUND LEVEL

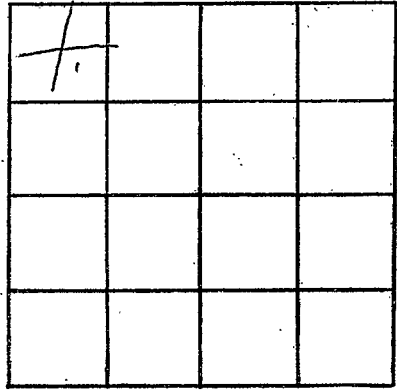

SECTION 4

Please indicate well location X.

ADDITIONAL INFORMATION

than one screen,
ions of each on sketch.