

MARION  
L. 2007  
4/25/77

MISSISSIPPI  
BOARD OF WATER COMMISSIONERS  
416 North State Street  
Jackson, Mississippi 39201

13U

WATER WELL DRILLERS LOG

4/25 1977 Hollinger Plumb's Well Marion  
date well completed firm name county well located

LANDOWNER: Earl Thomas  
RT 5  
Columbia Miss 39129  
(mailing address)

description of formations encountered	from	to
CHALK CLAY	0	15
sand gravel	15	30
sandy chalk clay	30	80
pea gravel	80	107

WELL LOCATION:  
sec. 21 T. 30 N. R. 18 E.  
2 1/2 miles S of Columbia  
(distance) (direction) (nearest town)

WELL PURPOSE: Home  
(home, irrigation, municipal, industrial)

WELL COMPLETION DATA:

(1) diameter (inches) 2"

(2) total depth (feet) 107

(3) static water level (feet) 6 <sup>below</sup> <sub>above</sub> top of ground.

(4) casing PVC, 102,  
(material) (depth)  
(size) If telescope see back.

(5) screen 5, 102  
(length) (depth to top)  
2", PVC  
(size) (material)

(6) pump 1/3, 8  
(HP) (yield gpm)  
elect  
(type power)

(7) electric log \_\_\_\_\_  
(yes or no)  
  
(organization running log)

(8) how well bottom plugged sand  
SHARK


DRILLERS REMARKS: Good well

RECEIVED  
JUN 15 1977

MISS. BU. OF WATER COMMISSIONERS

If well telescopes please sketch and show depths.

GROUND LEVEL

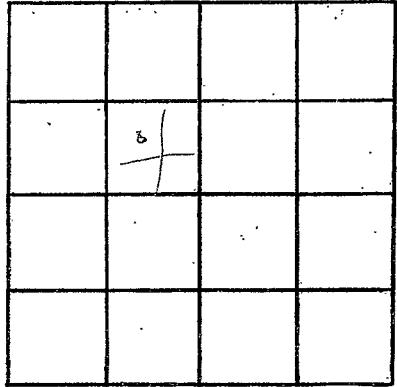

SECTION 21

Please indicate well location X.

ADDITIONAL INFORMATION

If more than one screen,  
show locations of each on sketch.