

MARION
 L 2009
 3-10-77

MISSISSIPPI
 BOARD OF WATER COMMISSIONERS
 416 North State Street
 Jackson, Mississippi 39201

WATER WELL DRILLERS LOG

3/10 1977 Hollinsek Water Well Marion
 date well completed firm name county well located

LANDOWNER: Robert Patten	description of formations encountered	from	to
North Church St.			
Columbia Miss 39429 (mailing address)	SAND, SHARK SAND, SPREAD	0	17 17-90

WELL LOCATION:
 sec. 8 T-3 N R-18 E
 city limits Columbia
 (distance) miles (direction) (nearest town)

WELL PURPOSE: Home
 (home, irrigation, municipal, industrial)

- WELL COMPLETION DATA:
- (1) diameter (inches) 4"
 - (2) total depth (feet) 90
 - (3) static water level (feet) 2 below top of ground.
 - (4) casing pvc 80
(material) (depth)
 - (size) If telescope see back.
 - (5) screen 10 80
(length) (depth to top)
 - 4 pvc
(size) (material)
 - (6) pump 1/2 12
(HP) (yield gpm)
 - elect
(type power)
 - (7) electric log (yes or no)
 - (organization running log)
 - (8) how well bottom plugged SAND SHARK


DRILLERS REMARKS: Very good

RECEIVED
 APR 26 1977

MISS. BD. OF WATER COMMISSIONERS

If well telescopes please sketch and show depths.

GROUND LEVEL

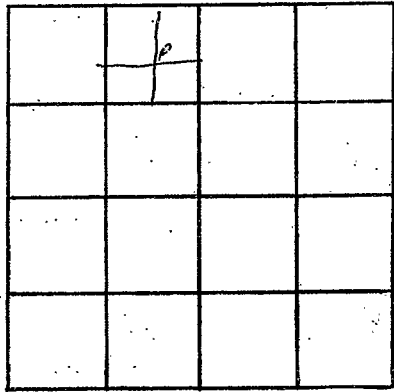

SECTION 8

Please indicate well location X.

ADDITIONAL INFORMATION

If more than one screen,
show locations of each on sketch.