

Marion
L 2010
7-3-79

MISSISSIPPI
BOARD OF WATER COMMISSIONERS
416 North State Street
Jackson, Mississippi 39201

WATER WELL DRILLERS LOG
TOM GRIFFITH
PLUMBING & WELL SERVICE, INC.
firm name

July 3, 1979
date well completed

Marion
Marion
county well located

LANDOWNER:
Ralph Thomas
Lakeview Sub Div. Columbia
(mailing address) *Miss*

description of formations encountered	from	to
Top Soil	0	1
Clay	1	6
Gravel	6	19
Gravel	19	36
Gravel	36	101
Gravel	101	165

WELL LOCATION:
sec. 2 T 3 N R 18 E
1 miles E of Columbia
(distance) (direction) (nearest town)

WELL PURPOSE: *Misc*
(home, irrigation, municipal, industrial)


- WELL COMPLETION DATA:
- (1) diameter (inches) 4"
 - (2) total depth (feet) 165 ft
 - (3) static water level (feet) 120 ft below above top of ground.
 - (4) casing plastic 80 ft
(material) (depth)
4"
(size) if telescope see back.
 - (5) screen 20 ft 80 ft
(length) (depth to top)
4" plastic
(size) (material)
 - (6) pump 1/2 HP 12 gpm
(HP) (yield gpm)
Electric
(type power)
 - (7) electric log no
(yes or no)
- (organization running log)
- (8) how well bottom plugged Back Wash Valve

Rec'd 9/21/79
DML-LW

DRILLERS REMARKS:

If well telescopes please sketch and show depths.

GROUND LEVEL

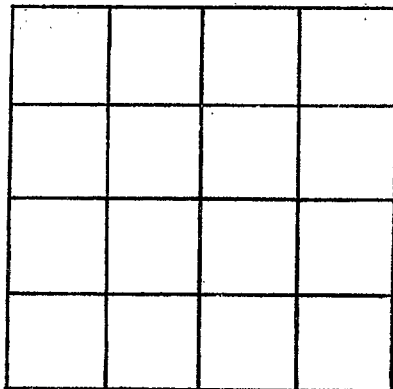

SECTION _____

Please indicate well location X.

ADDITIONAL INFORMATION

If more than one screen,
show locations of each on sketch.