

Marion
L
2011
8-6-79
8/6

MISSISSIPPI
 BOARD OF WATER COMMISSIONERS
 416 North State Street
 Jackson, Mississippi 39201

WATER WELL DRILLERS LOG

TOM GRIFFITH
 PLUMBING & WELL SERVICE, INC.

date well completed

firm name

county well located

Marion

LANDOWNER:	description of formations encountered	from	to
<u>Mr. Hermon Morgan</u> <u>Rt. 2 - Box 41 Columbia</u> (mailing address) <u>Miss.</u>	<u>Top Soil</u> <u>Chalk</u> <u>Loam</u> <u>Chalk</u> <u>Loam</u>	<u>0</u> <u>2</u> <u>18</u> <u>31</u> <u>31</u> <u>179</u>	<u>2</u> <u>18</u> <u>31</u> <u>179</u> <u>225</u>
WELL LOCATION:			
sec. <u>11</u> T. <u>3</u> N. R. <u>12</u> E. <u>S</u>			
(distance) _____ miles _____ of _____ (direction) (nearest town)			
WELL PURPOSE: <u>Home</u> (home, irrigation, municipal, industrial)			
WELL COMPLETION DATA:			
(1) diameter (inches) <u>2"</u>			
(2) total depth (feet) <u>225 ft.</u>			
(3) static water level (feet) <u>120 ft.</u> ^{below} / _{above} top of ground.			
(4) casing <u>plastic</u> <u>205 ft.</u> (material) (depth)			
<u>2"</u> (size) If telescope see back.			
(5) screen <u>20 ft.</u> <u>205 ft.</u> (length) (depth to top)			
<u>2"</u> <u>plastic</u> (size) (material)			
(6) pump <u>1 Hp</u> <u>10</u> (HP) (yield gpm)			
<u>Electric</u> (type power)			
(7) electric log <u>No</u> (yes or no)			
_____ (organization running log)			
(8) how well bottom plugged <u>B.W. Valve</u>			
DRILLERS REMARKS:			


DEPT. OF NATURAL RESOURCES
 BUREAU OF LAND & WATER RESOURCES

NOV 21 1979

RECEIVED

If well telescopes please sketch and show depths.

GROUND LEVEL

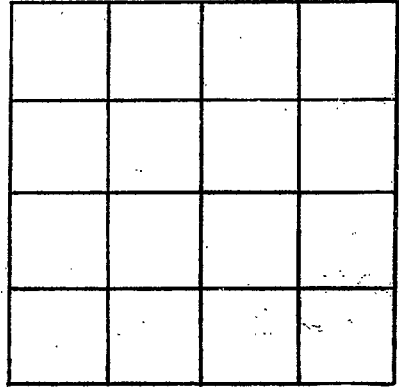

SECTION _____

Please indicate well location X.

ADDITIONAL INFORMATION

If more than one screen, show locations of each on sketch.