

This location 3 mi S south of Columbia.

MARION
L 2012
9-24-80

MISSISSIPPI
BOARD OF WATER COMMISSIONERS
416 North State Street
Jackson, Mississippi 39201

WATER WELL DRILLERS LOG

9/24/80 date well completed
Tom Brown Drillers firm name
MARION county well located

LANDOWNER: Carl Lott
Rt. 2 Box 316
City Columbia
(mailing address)

description of formations encountered	from	to
TOPSOIL	5'	1'
SAND & pea GRAVEL	1'	45'
CHALK	45'	105'
SAND	105'	170'

WELL LOCATION:
sec 26 T. 3 N R. 18 E
10' miles SE of Columbia
(distance) (direction) (nearest town)

WELL PURPOSE: HOME
(home, irrigation, municipal, industrial)

- WELL COMPLETION DATA:
- (1) diameter (inches) 4"
 - (2) total depth (feet) 170
 - (3) static water level (feet) 90' below top of ground.
 - (4) casing PLASTIC, 170'
(material) (depth)
4" If telescope see back.
(size)
 - (5) screen 20' 150'
(length) (depth to top)
4" plastic
(size) (material)
 - (6) pump 3/4 HP 12
(HP) (yield gpm)
ELECT (type power)
 - (7) electric log _____
(yes or no)

(organization running log)
 - (8) how well bottom plugged _____

DEPT. OF NATURAL RESOURCES
BUREAU OF LAND & WATER RESOURCES


OCT - 6 1980

RECEIVED

DRILLERS REMARKS:

If well telescopes please sketch and show depths.

GROUND LEVEL

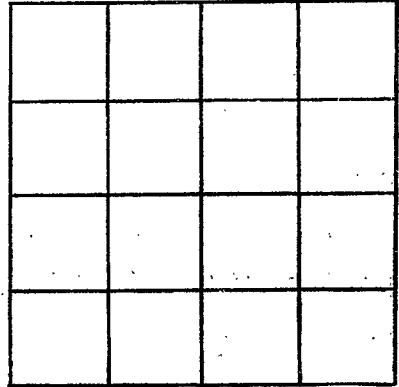

SECTION _____

Please indicate well location X.

ADDITIONAL INFORMATION

If more than one screen, show locations of each on sketch.