

Marion
L 2013
4-3-80

MISSISSIPPI
BOARD OF WATER COMMISSIONERS
416 North State Street
Jackson, Mississippi 39201

WATER WELL DRILLERS LOG

4-3 1980 Hollinger SMACW
date well completed firm name county well located

LANDOWNER: Quinn Strong
Hwy 98 E
Columbia Ms.
(mailing address)

description of formations encountered	from	to
sand, chalk	80	80
GRAVEL, sand	80	115
COARSE SAND	115	140

WELL LOCATION:
sec 32 T 30 N R 18 E
S W
6 miles E of Columbia
(distance) (direction) (nearest town)

WELL PURPOSE:
(home, irrigation, municipal, industrial)

- WELL COMPLETION DATA:
- (1) diameter (inches) 4
 - (2) total depth (feet) 140
 - (3) static water level (feet) 50 ^{below} above top of ground.
 - (4) casing PVC, 130,
(material) (depth)
(size) If telescope see back.
 - (5) screen 10, 130
(length) (depth to top)
4, PVC
(size) (material)
 - (6) pump 1/2, 8
(HP) (yield gpm)
elect
(type power)
 - (7) electric log _____
(yes or no)

(organization running log)
 - (8) how well bottom plugged sand
SHARK

DRILLERS REMARKS: good well


DEPT. OF NATURAL RESOURCES
BUREAU OF LAND & WATER RESOURCES

APR 14 1980

RECEIVED

If well telescopes please sketch and show depths.

GROUND LEVEL

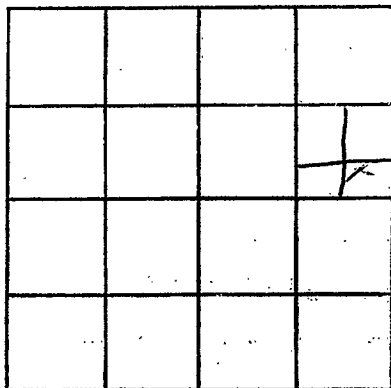

SECTION 32

Please indicate well location X.

ADDITIONAL INFORMATION

If more than one screen, show locations of each on sketch.