

Monroe
L2014

MISSISSIPPI
BOARD OF WATER COMMISSIONERS
416 North State Street
Jackson, Mississippi 39201

WATER WELL DRILLERS LOG

3/25/42 19
date well completed

TOM GRIFFITH
PLUMBING & WELL SERVICE, INC.
driller name

Monroe
county well located


LANDOWNER:	description of formations encountered	from	to
<u>Jennie Taylor</u> <u>186 Columbia, Mo</u> (mailing address)			
	<u>Chalk</u>	<u>1</u>	<u>20</u>
	<u>sand</u>	<u>20</u>	<u>90</u>
WELL LOCATION: sec. <u>26T3</u> <u>N</u> R. <u>18E</u> <u>4</u> miles <u>N</u> of <u>Columbia</u> (distance) (direction) (nearest town)			
WELL PURPOSE: <u>Home</u> (home, irrigation, municipal, industrial)			
WELL COMPLETION DATA:			
(1) diameter (inches) <u>4"</u>			
(2) total depth (feet) <u>90'</u>			
(3) static water level (feet) <u>35'</u> ^{below} _{above} top of ground.			
(4) casing <u>PVC</u> , 70' <u>70'</u> (material) (depth)			
<u>4"</u> if telescope see back. (size)			
(5) screen <u>10'</u> , <u>70'</u> (length) (depth to top)			
<u>4"</u> , <u>PVC</u> (size) (material)			
(6) pump <u>12</u> <u>10</u> (HP) (yield gpm)			
<u>90W</u> (type power)			
(7) electric log <u>No</u> (yes or no)			
<u>n/a</u> (organization running log)			
(8) how well bottom plugged <u>130W</u>			
DRILLERS REMARKS:			

DEPT. OF NATURAL RESOURCES
BUREAU OF LAND & WATER RESOURCES

JUN - 9 1982
RECEIVED

If well telescopes please sketch and show depths.

GROUND LEVEL

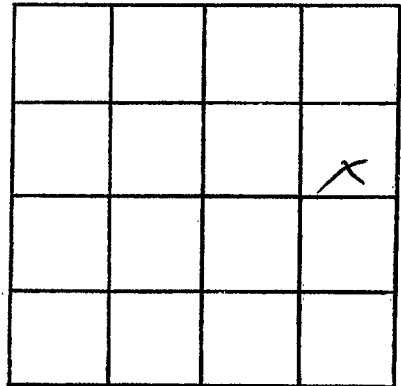

SECTION 76

Please indicate well location X.

ADDITIONAL INFORMATION

If more than one screen, show locations of each on sketch.