

Marion  
L  
2018

MISSISSIPPI DEPARTMENT OF NATURAL RESOURCES

Bureau of Land and Water Resources

Southport Mall

P.O. Box 10631

Jackson, Mississippi 39209

WATER WELL DRILLERS LOG

TOM GRIFFITH

PLUMBING & WELL SERVICE, INC.

Marion

2-15 1984  
date well completed

320 MAYSON AVE.

county well located

COLUMBIA, MS 39429

LANDOWNER: Don Smith

description of formations encountered

from

to

R.1

Chalk

1' 10'

Columbia, MS 39429

Gravel

10' 30'

(mailing address)

WELL LOCATION:

sec. 35 T 30 N R 18 E  
S W  
4 miles N of Hub  
(distance) (direction) (nearest town)

WELL PURPOSE: Home  
(home, irrigation, municipal, industrial)

WELL COMPLETION DATA:

- (1) diameter (inches) 4"
- (2) total depth (feet) 30'
- (3) static water level (feet) 10' below top of ground.
- (4) casing PVC, 25', (material) (depth)  
N/A (size) if telescope see back.
- (5) screen 5', 35', (length) (depth to top)  
4" PVC (size) (material)
- (6) pump 1/2, 12 (HP) (yield gpm)  
Elec. (type power)
- (7) electric log N/A (yes or no)  
N/A (organization running log)
- (8) how well bottom plugged BWV


DRILLERS REMARKS:

DEPT. OF NATURAL RESOURCES  
BUREAU OF LAND & WATER RESOURCES

MAY - 2 1984  
RECEIVED

If well telescopes please sketch and show depths.

GROUND LEVEL

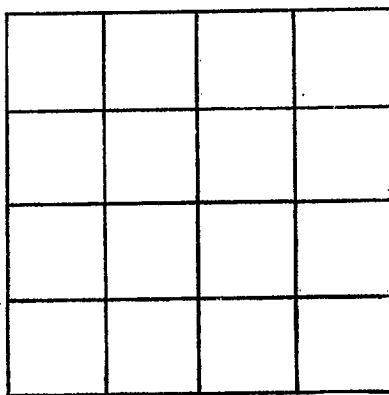

SECTION \_\_\_\_\_

Please indicate well location X.

ADDITIONAL INFORMATION

If more than one screen,  
show locations of each on sketch.