

MISSISSIPPI DEPARTMENT OF NATURAL RESOURCES

Bureau of Land and Water Resources

Southport Mall

P.O. Box 10631

Jackson, Mississippi 39209

WATER WELL DRILLERS LOG

Marion  
L  
2020

11/01/86 19 Tom Caruth Well Service Marion  
 date well completed firm name county well located

LANDOWNER: <u>John Harvey</u>	description of formations encountered		from	to
(mailing address)	<u>CLAY</u>		<u>1</u>	<u>60</u>
	<u>SAND</u>		<u>60</u>	<u>90</u>
	<u>CLAY</u>		<u>90</u>	<u>120</u>
WELL LOCATION: sec. <u>3</u> T. <u>3</u> S. R. <u>18</u> E. <u>W</u> <u>Columbia</u>	<u>SAND</u>		<u>120</u>	<u>160</u>
(distance) miles _____ of _____ (direction) (nearest town)				
WELL PURPOSE: <u>HEAT PUMP</u> (home, irrigation, municipal, industrial)				
WELL COMPLETION DATA:				
(1) diameter (inches) <u>4"</u>				
(2) total depth (feet) <u>160'</u>				
(3) static water level (feet) <u>70</u> <sup>below</sup> above top of ground.				
(4) casing <u>PVC</u> <u>140'</u> (material) (depth) <u>4"</u> (size) if telescope see back.				
(5) screen <u>20</u> <u>140'</u> (length) (depth to top) <u>4"</u> <u>PVC</u> (size) (material)				
(6) pump _____ <u>40</u> (HP) (yield gpm) _____ (type power)				
(7) electric log <u>No</u> (yes or no) <u>NA</u> (organization running log)				
(8) how well bottom plugged <u>SWV</u>				

RECEIVED


NOV 7 1986

Department of Natural Resources  
 Bureau of Land & Water Resources

DRILLERS REMARKS:

If well telescopes please  
sketch and show depths.

GROUND LEVEL

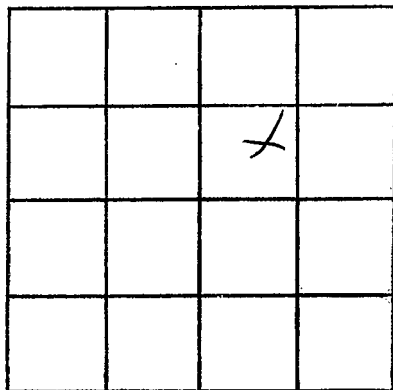

SECTION \_\_\_\_\_

Please indicate well location X.

ADDITIONAL INFORMATION

If more than one screen,  
show locations of each on sketch.